



NOTES / REVISIONS


NOTE: THIS DRAWING MUST NOT BE SCALED.
 ALL DIMENSIONS TO BE CHECKED ON SITE BY THE CONTRACTOR AND ANY DISCREPANCIES ARE TO BE REPORTED BACK TO THE ARCHITECTS A. BEFORE WORK COMMENCES.
 revision a: insulation of roof over Games Room added - mdc - 13 June 2017
 revision b: work to Lounge omitted; removal of first floor ceilings noted - mdc - 11 July 2017

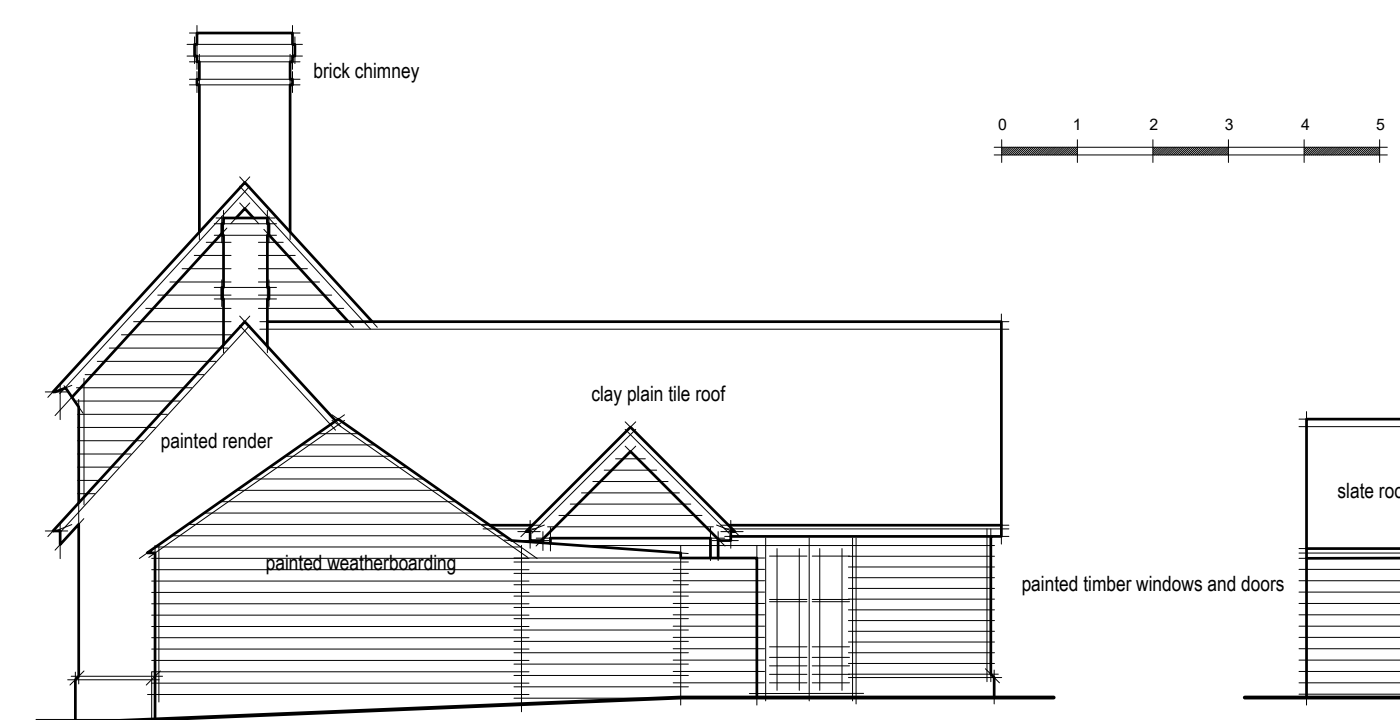


north elevation

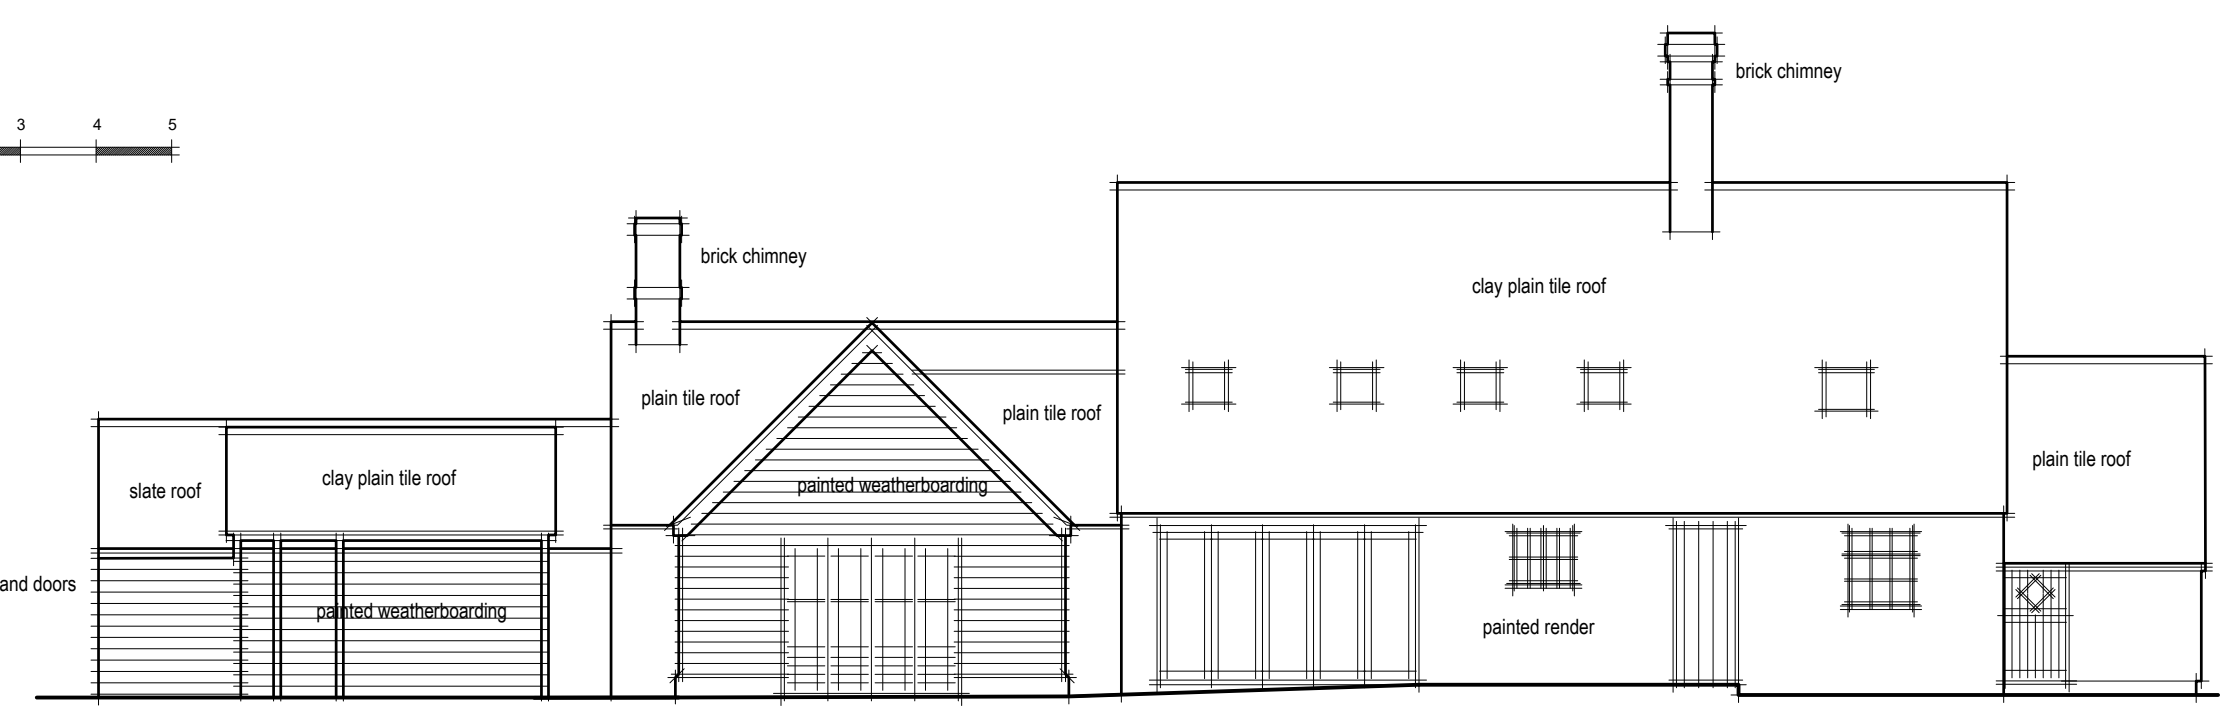


west elevation

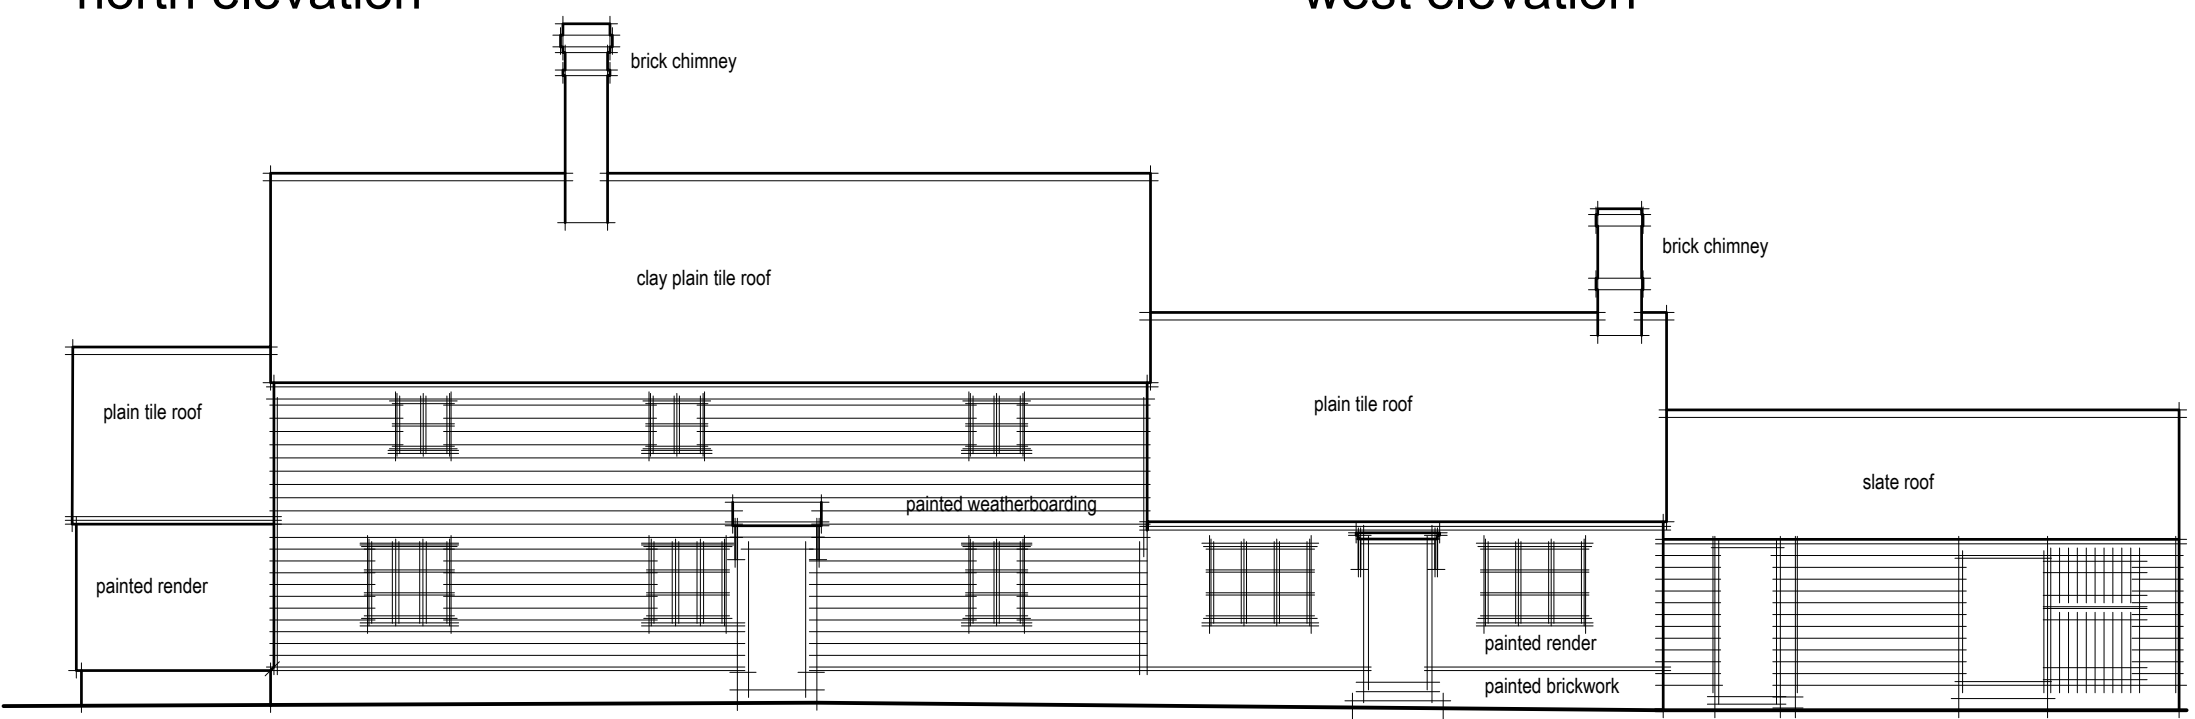


east elevation

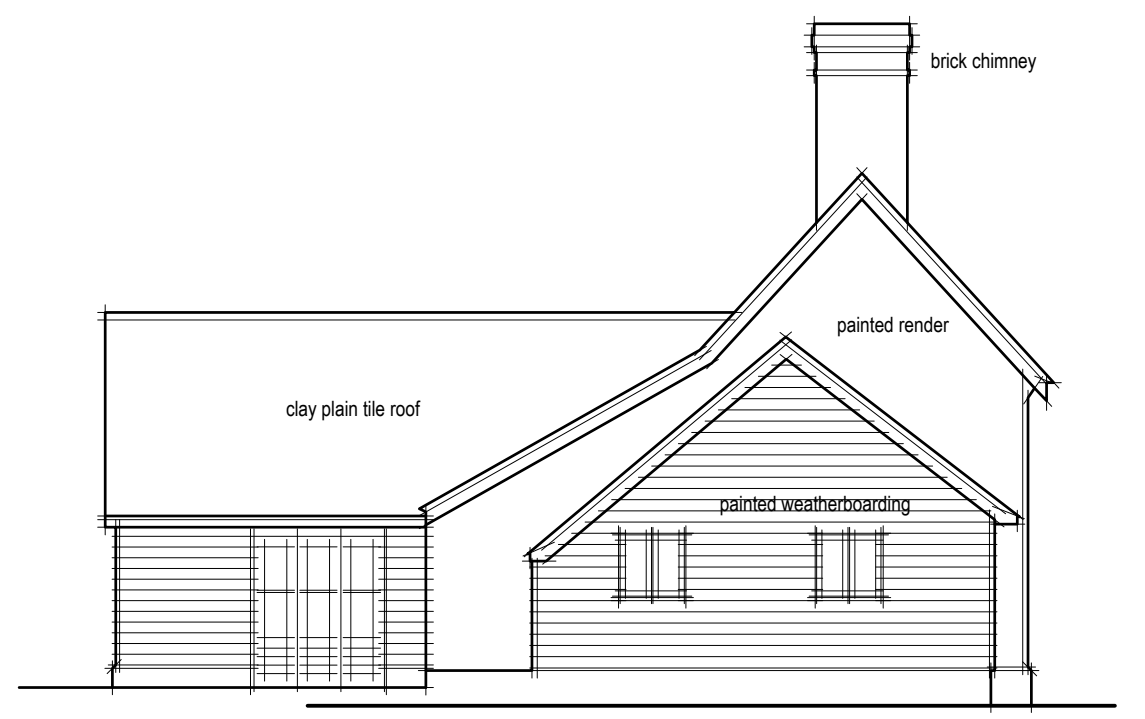


south elevation

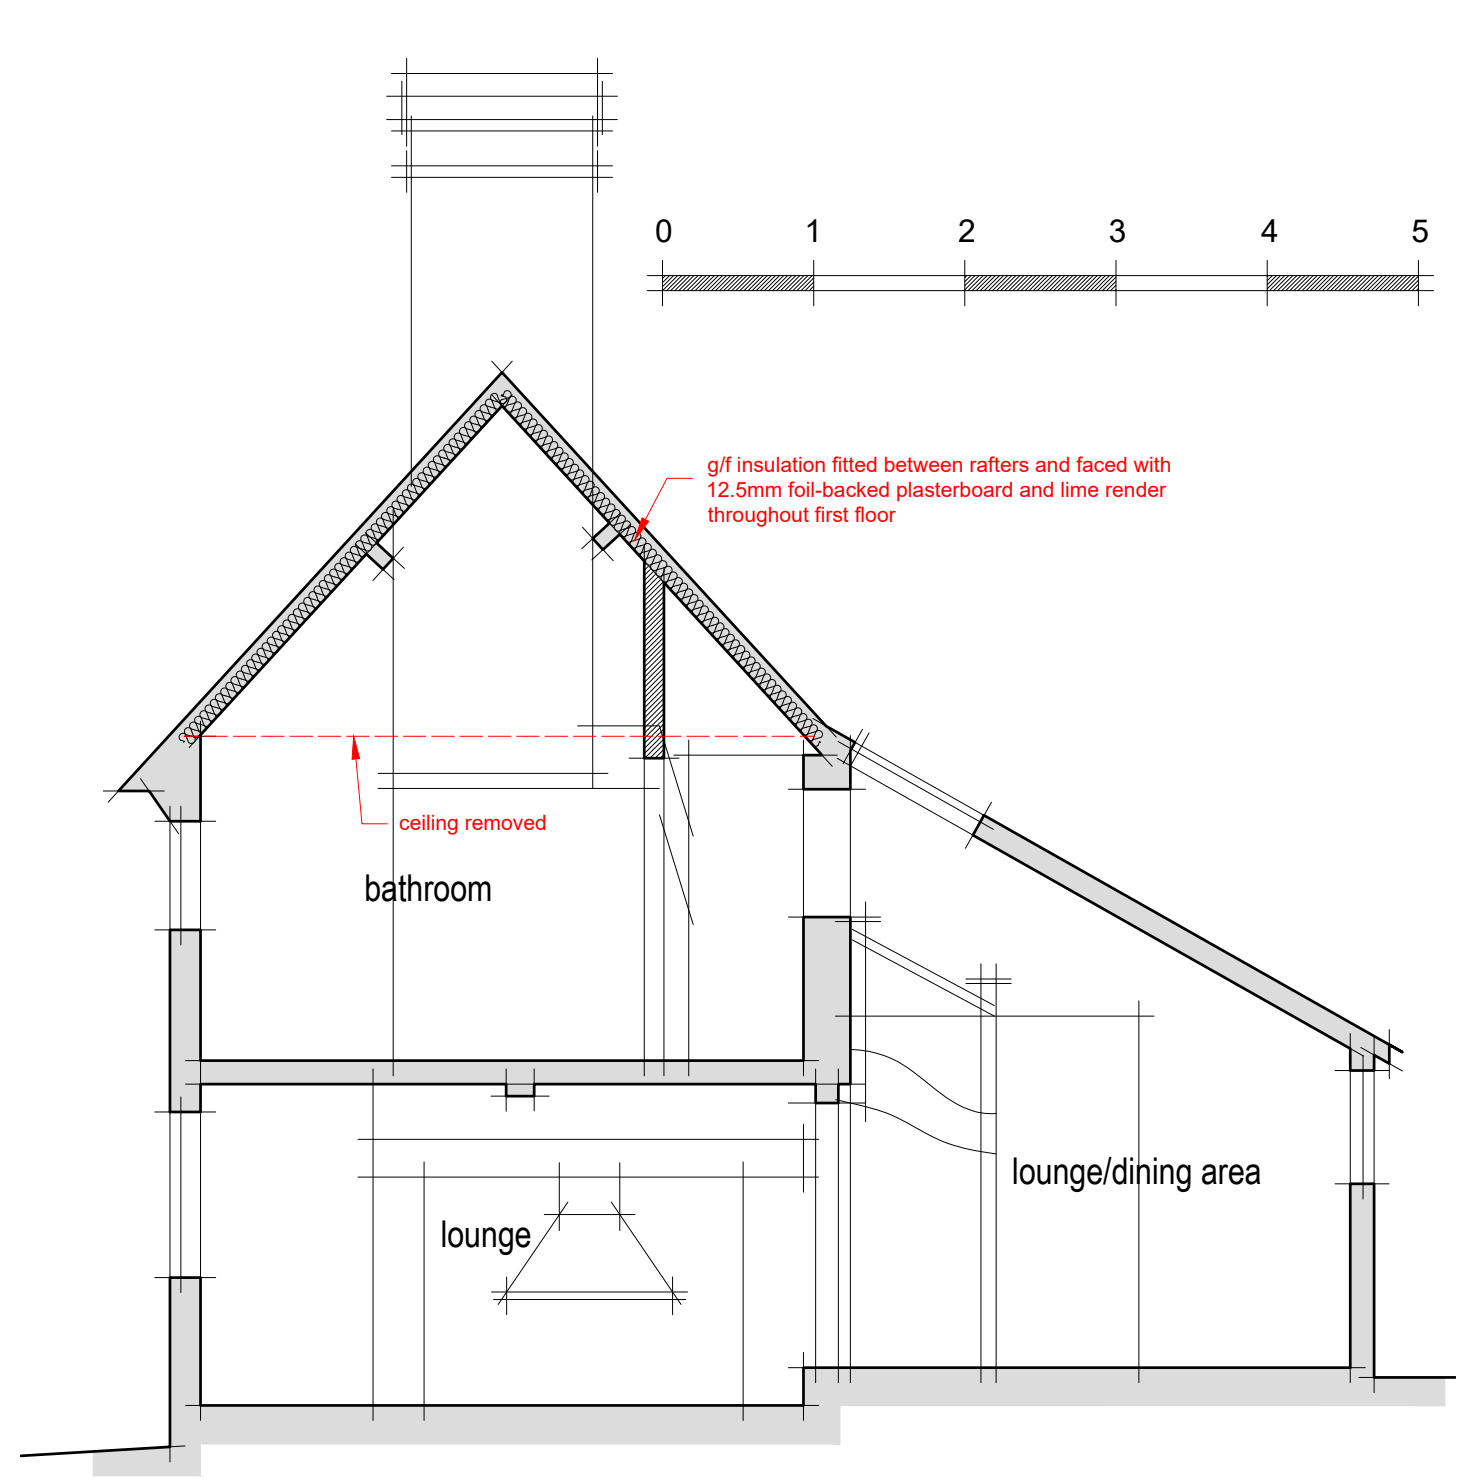


typical section

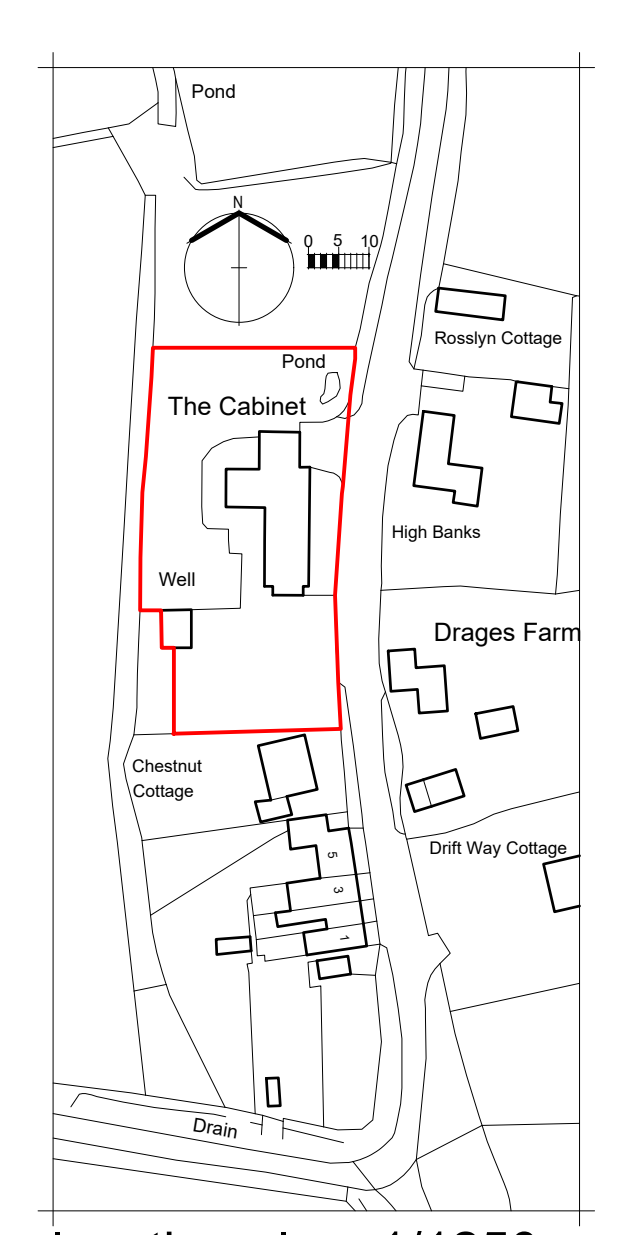

location plan 1/1250

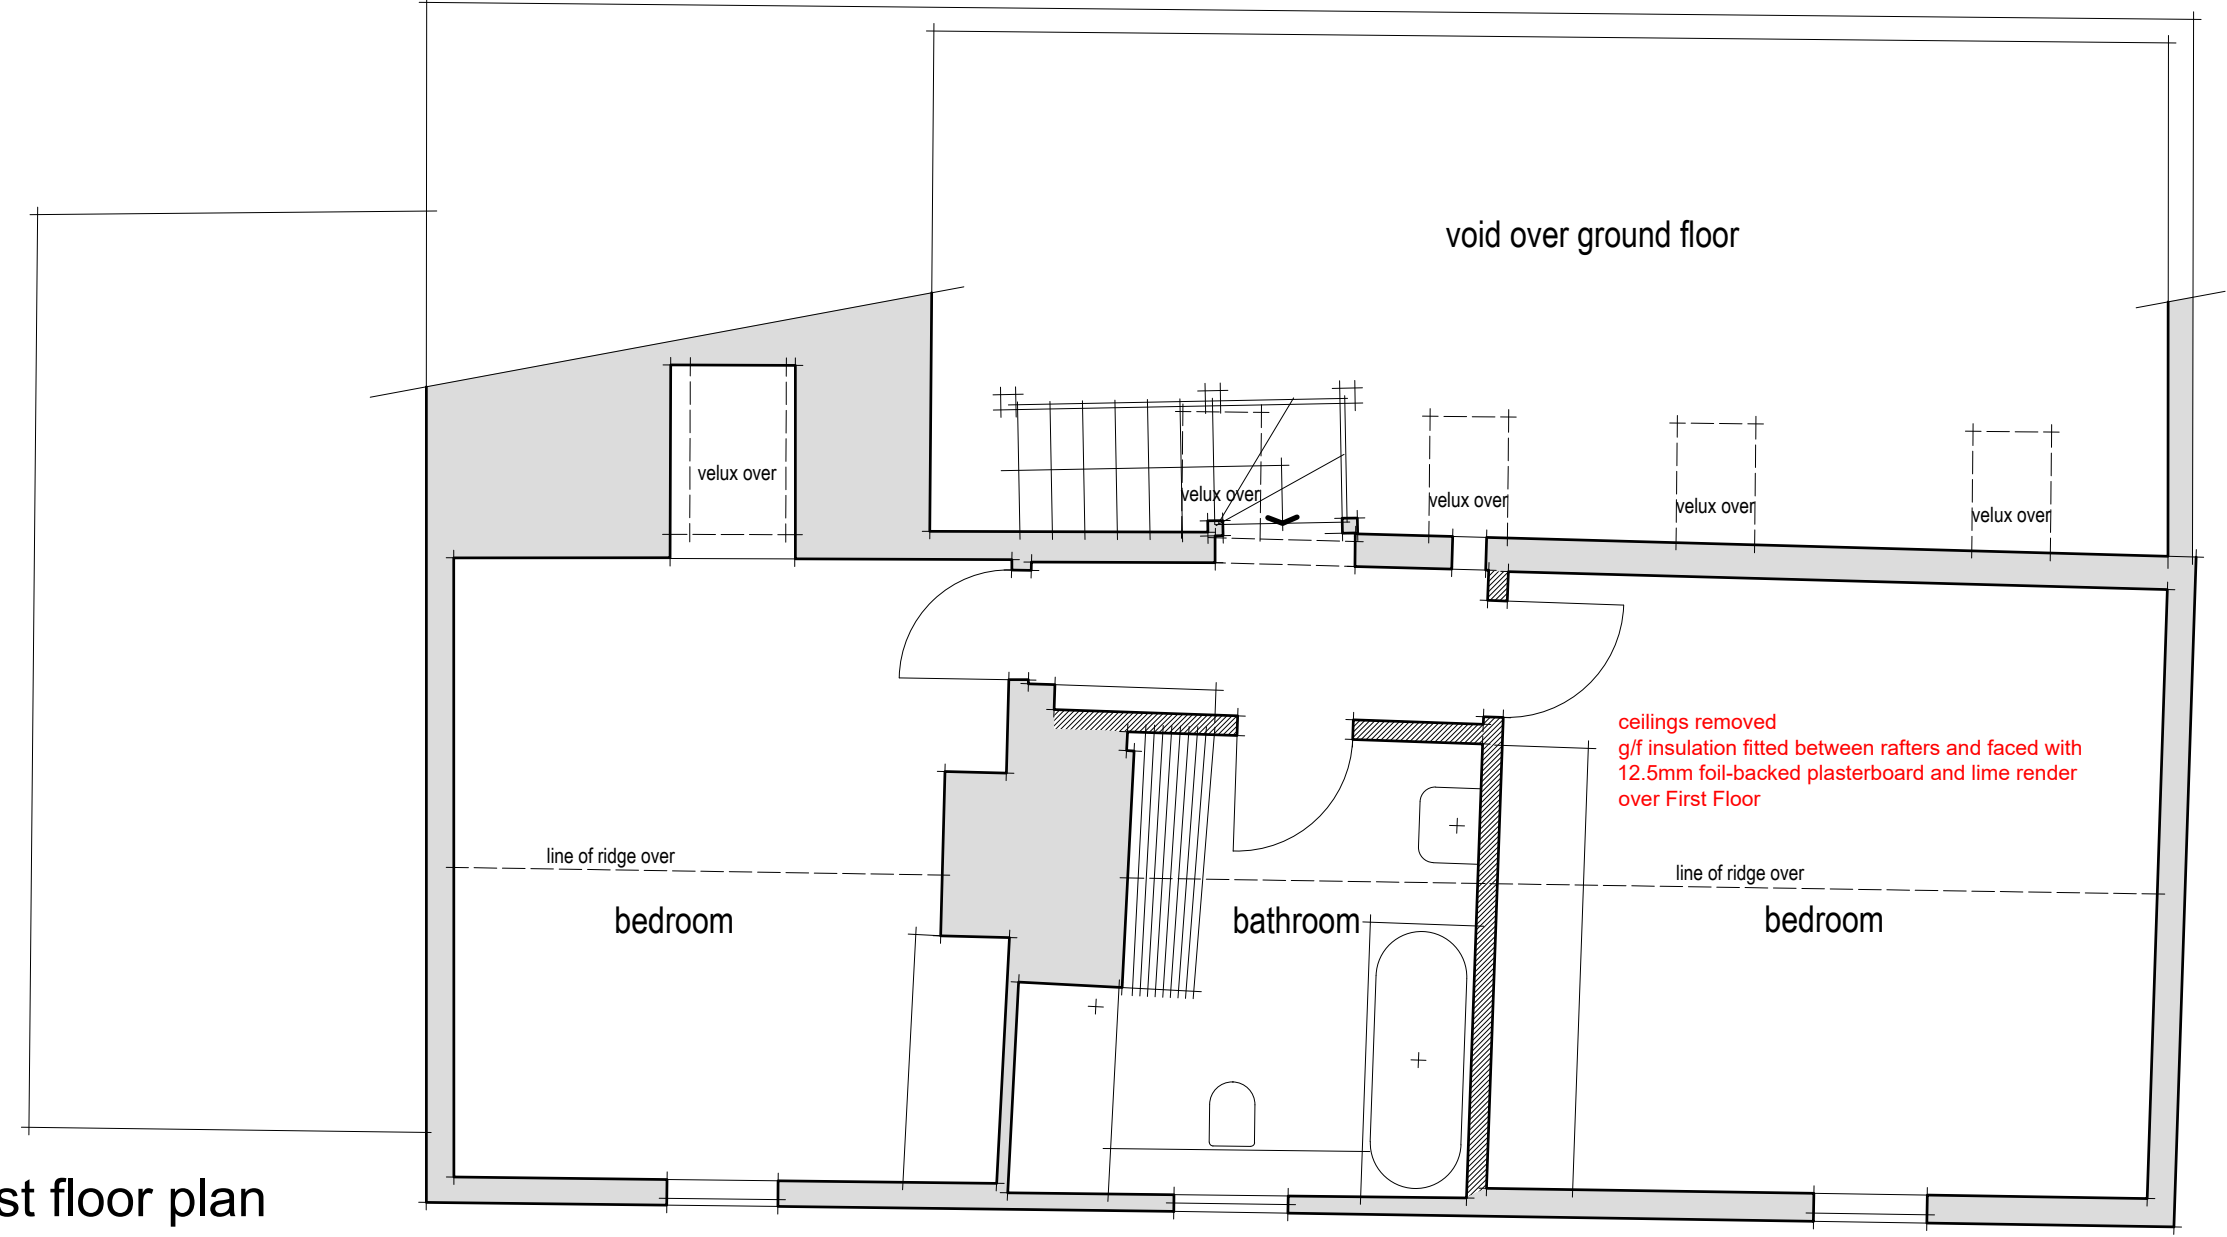


first floor plan

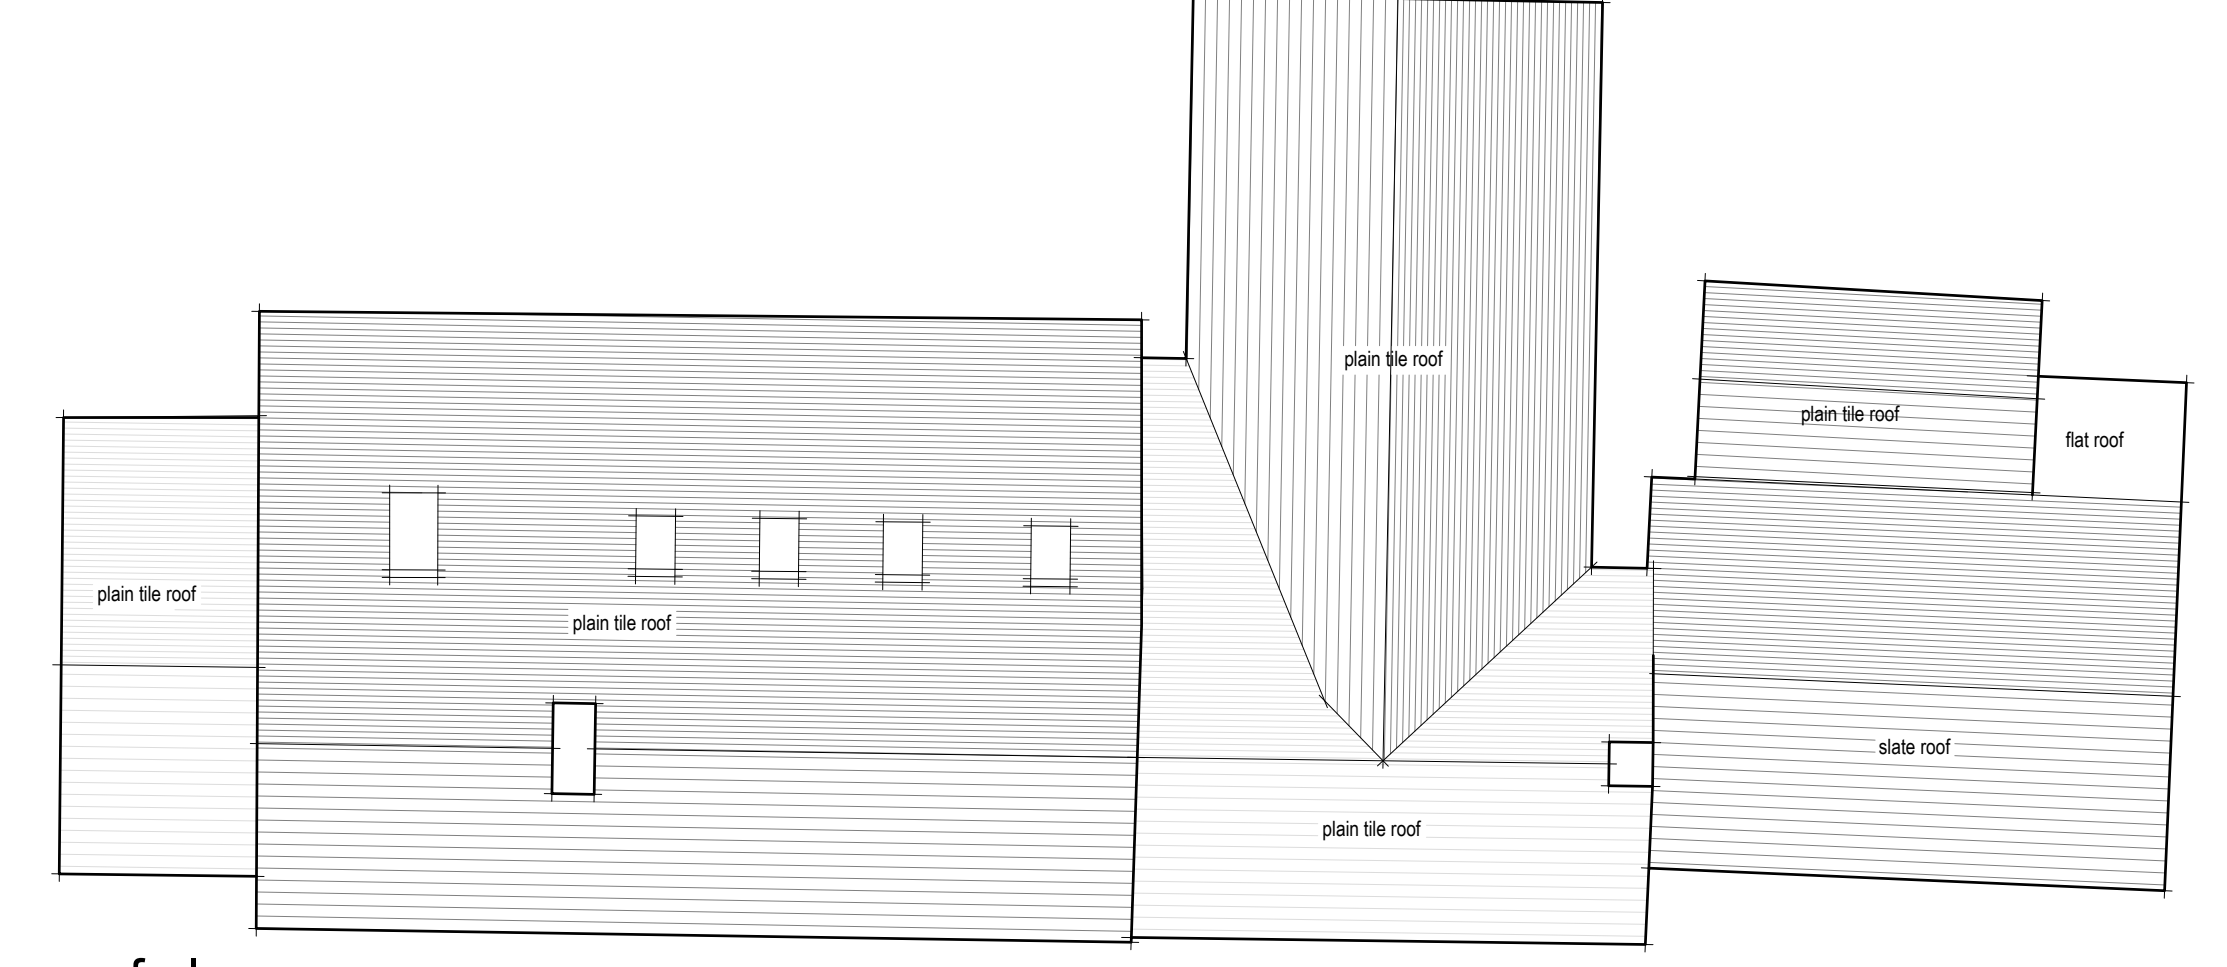

roof plan

PREMISES SHOWN AS SURVEYED ON 20 JULY 2016
 WORKS UNDERTAKEN WITHOUT LISTED BUILDING CONSENT SHOWN IN RED

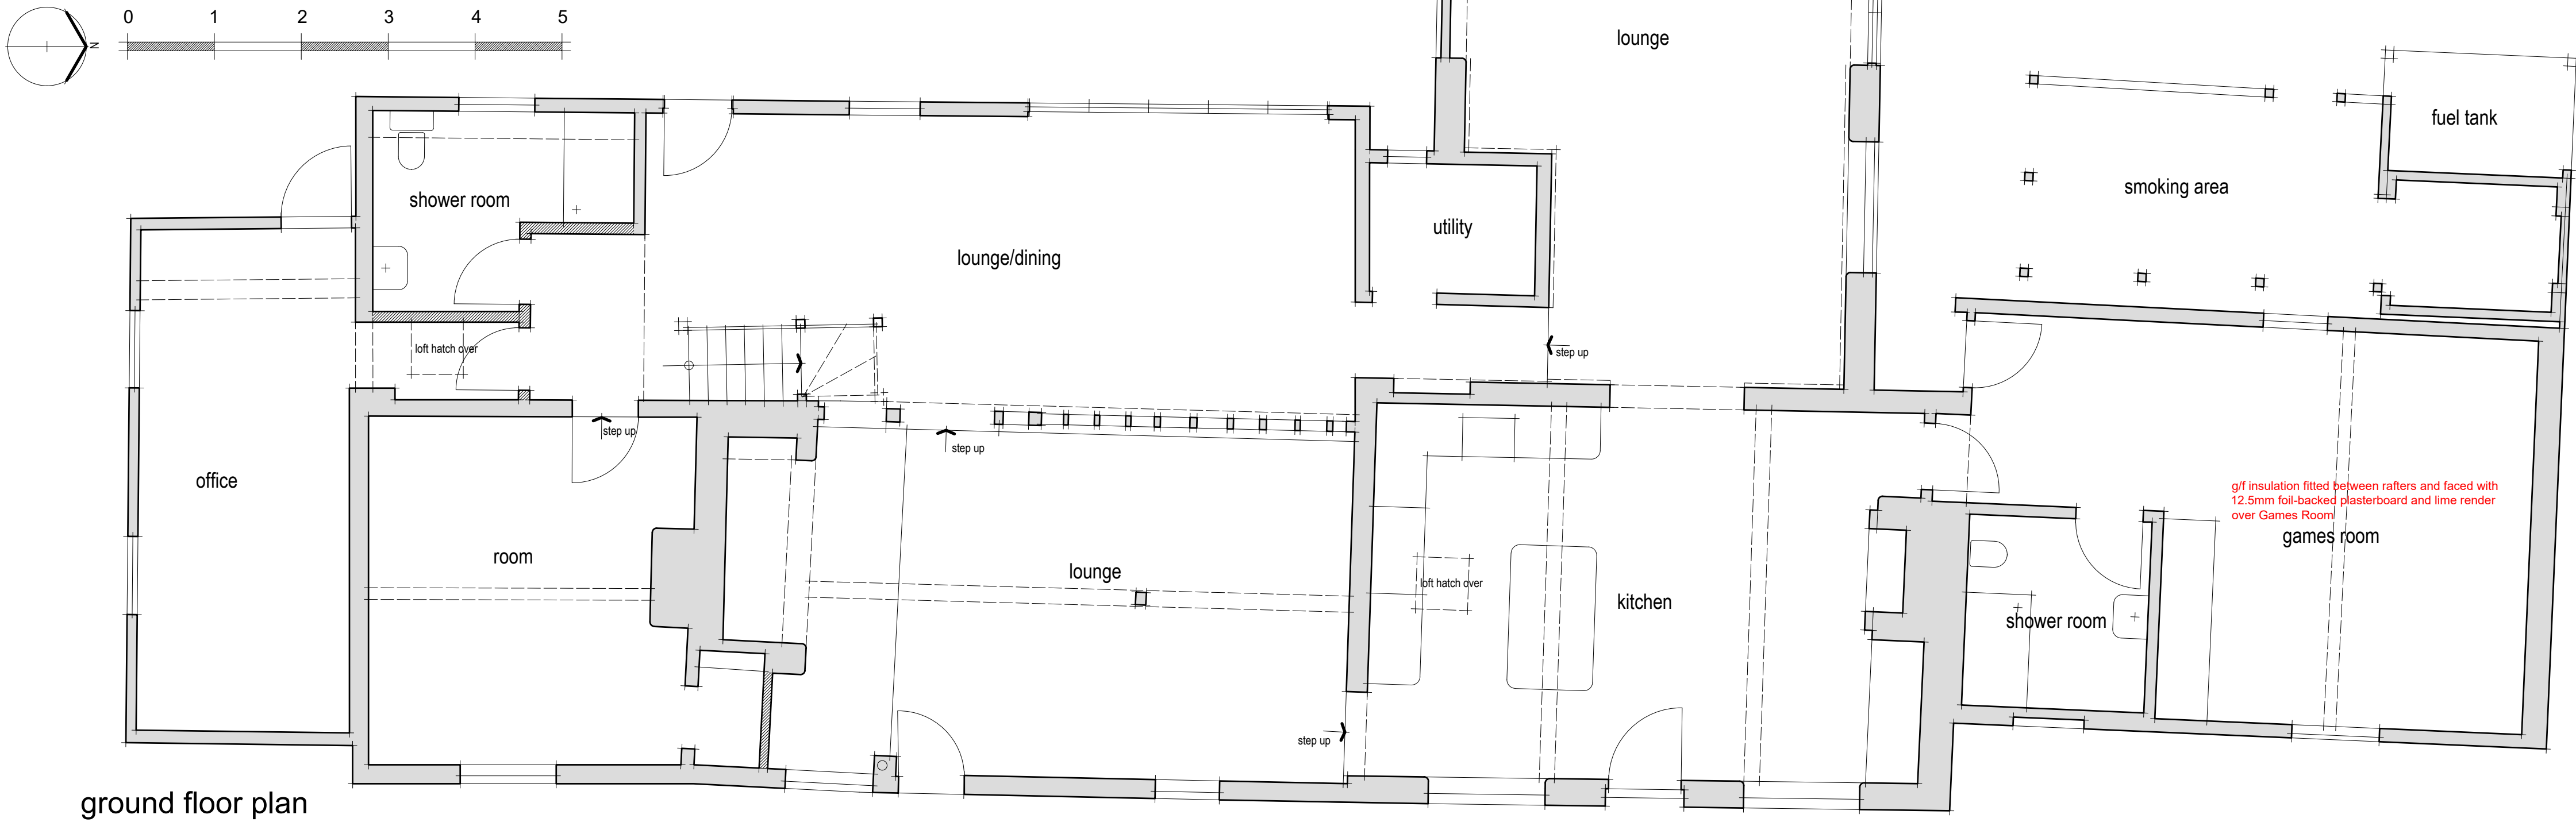

ground floor plan

PROJECT:	THE CABINET HIGH STREET REID HERTS SG8 8AH	<p>Parndon Mill Harlow Essex CM20 2HP T: 01279 444 904 E: info@sandds.co.uk W: www.sandds.co.uk</p>
DRAWING:	EXISTING PLANS SECTION ELEVATIONS	
DATE:	JUNE 2017	
SCALE:	1/50 1/100 at A1	
DRAWING NUMBER:	16/001/A/02 B	
DRAWN BY: MDC CHECKED:		