



NOTES / REVISIONS


NOTE: THIS DRAWING MUST NOT BE SCALED.
 ALL DIMENSIONS TO BE CHECKED ON SITE BY THE CONTRACTOR AND ANY DISCREPANCIES ARE TO BE REPORTED BACK TO THE ARCHITECTS A BEFORE WORK COMMENCES.
 revision a: insulation of roof over Games Room added - mdc - 13 June 2017
 revision b: work to Lounge omitted; removal of first floor ceilings noted - mdc - 11 July 2017

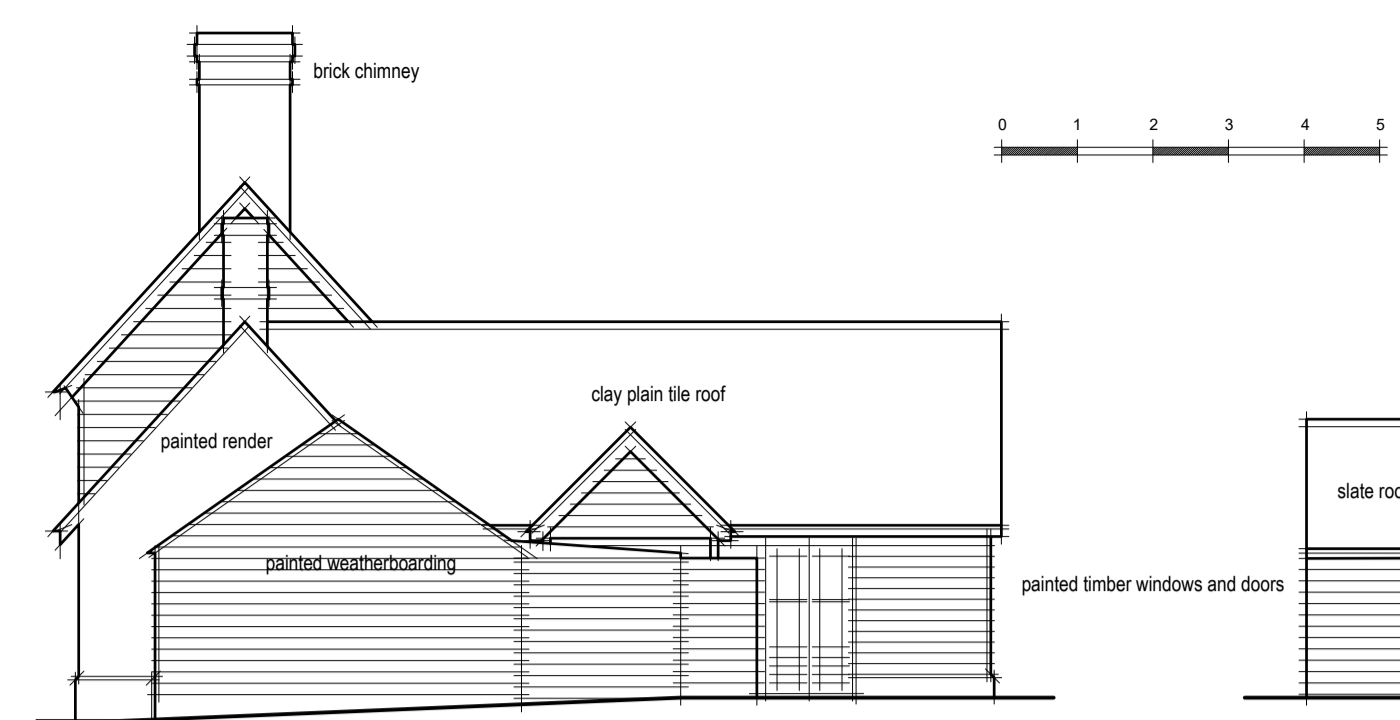


north elevation

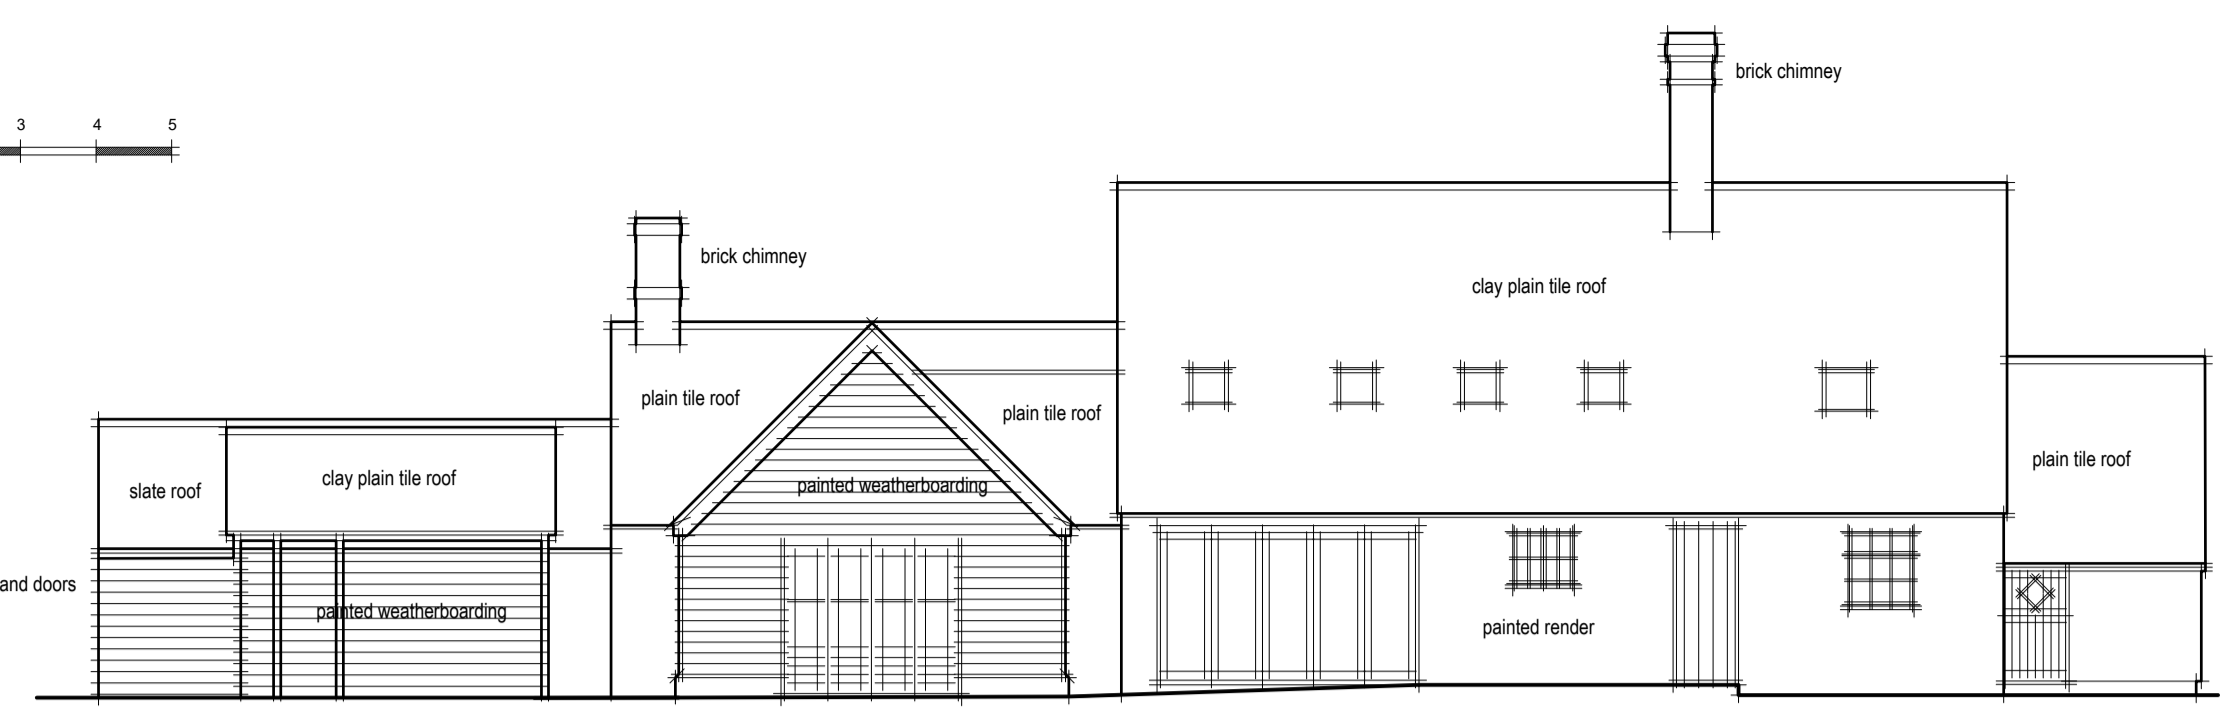


west elevation

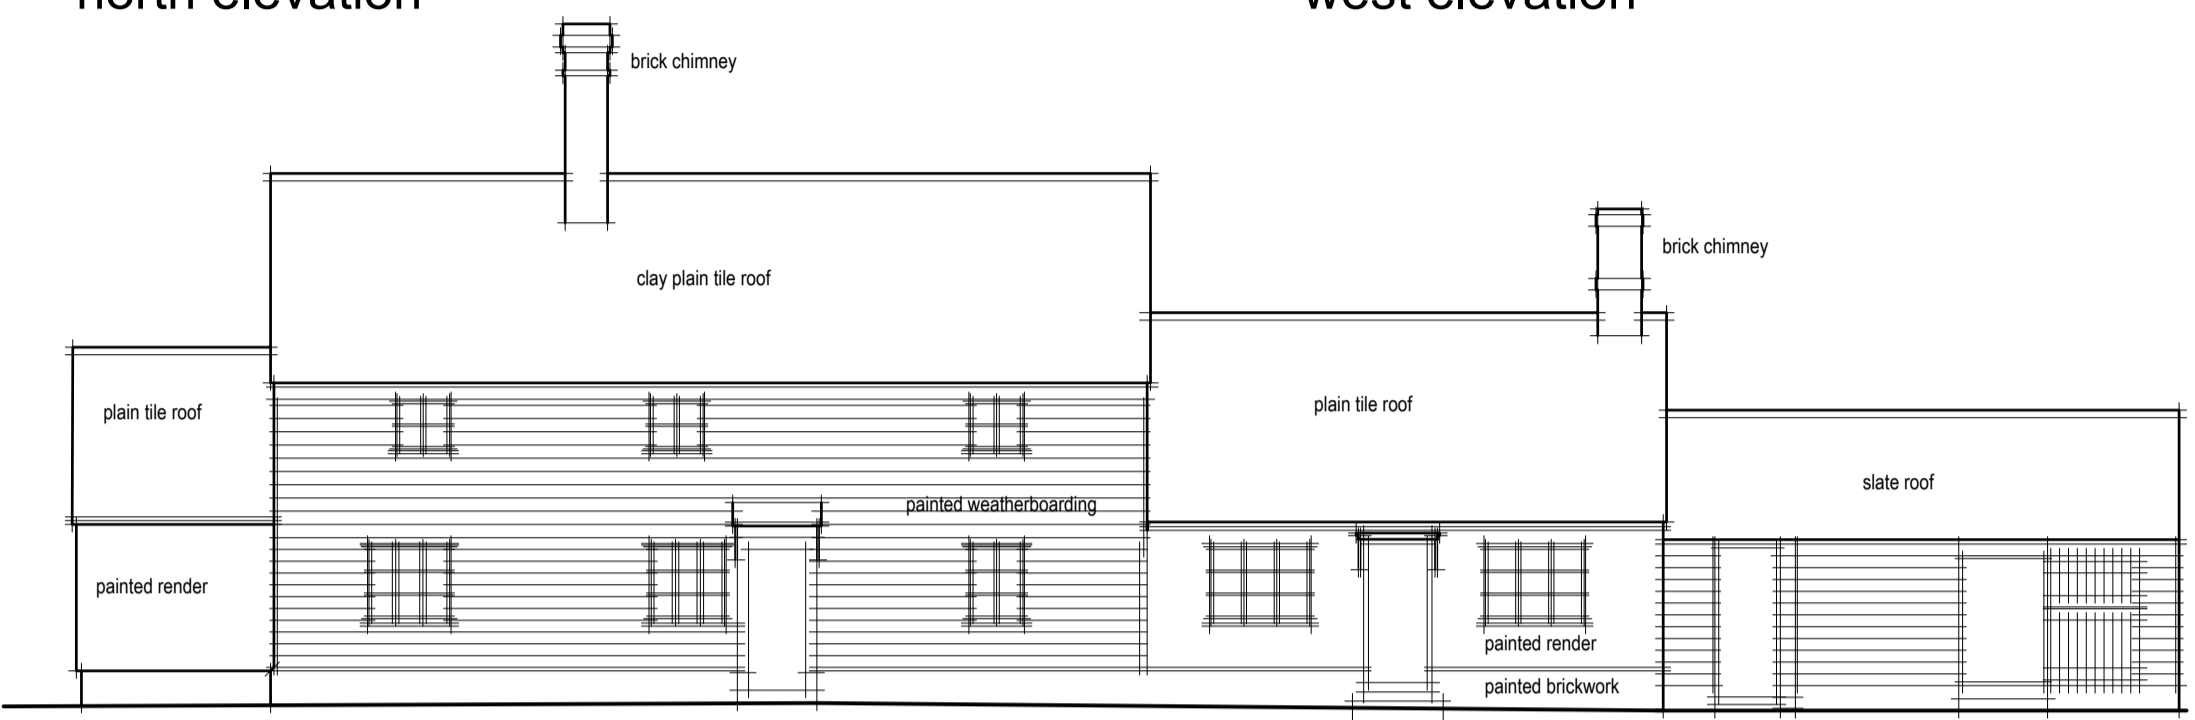


east elevation

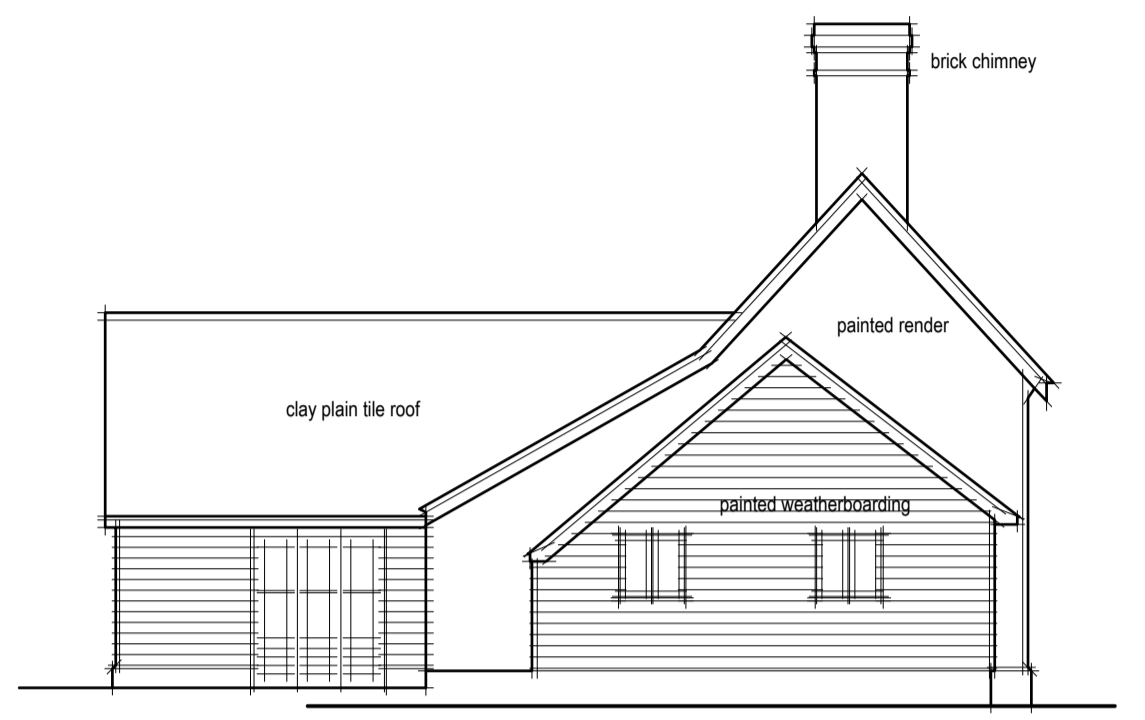


south elevation

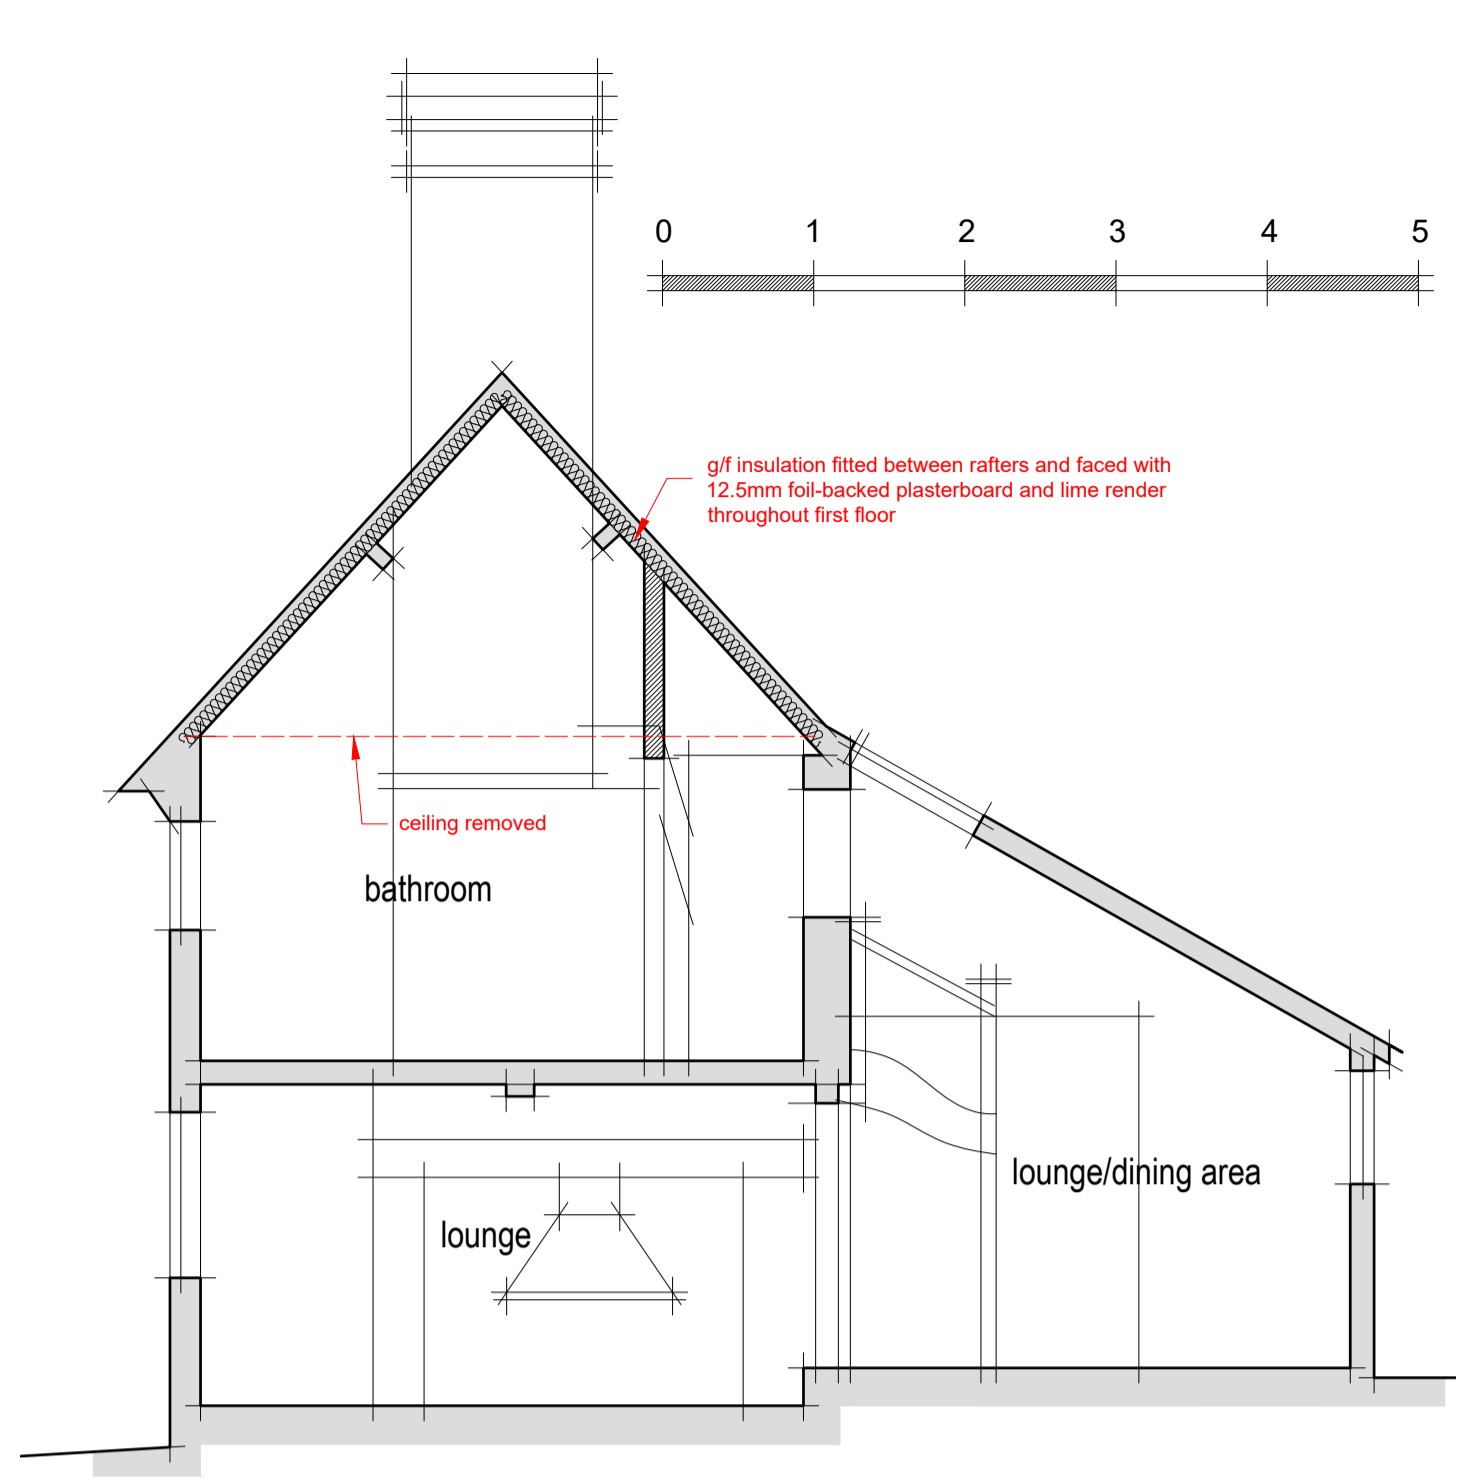


typical section

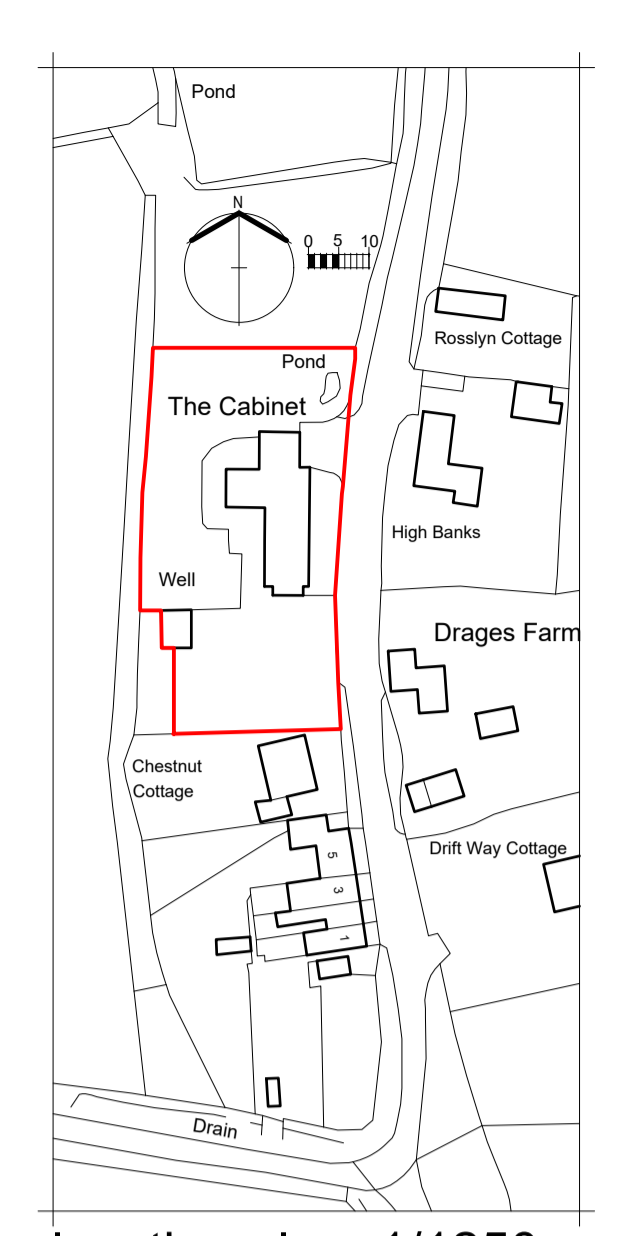

location plan 1/1250

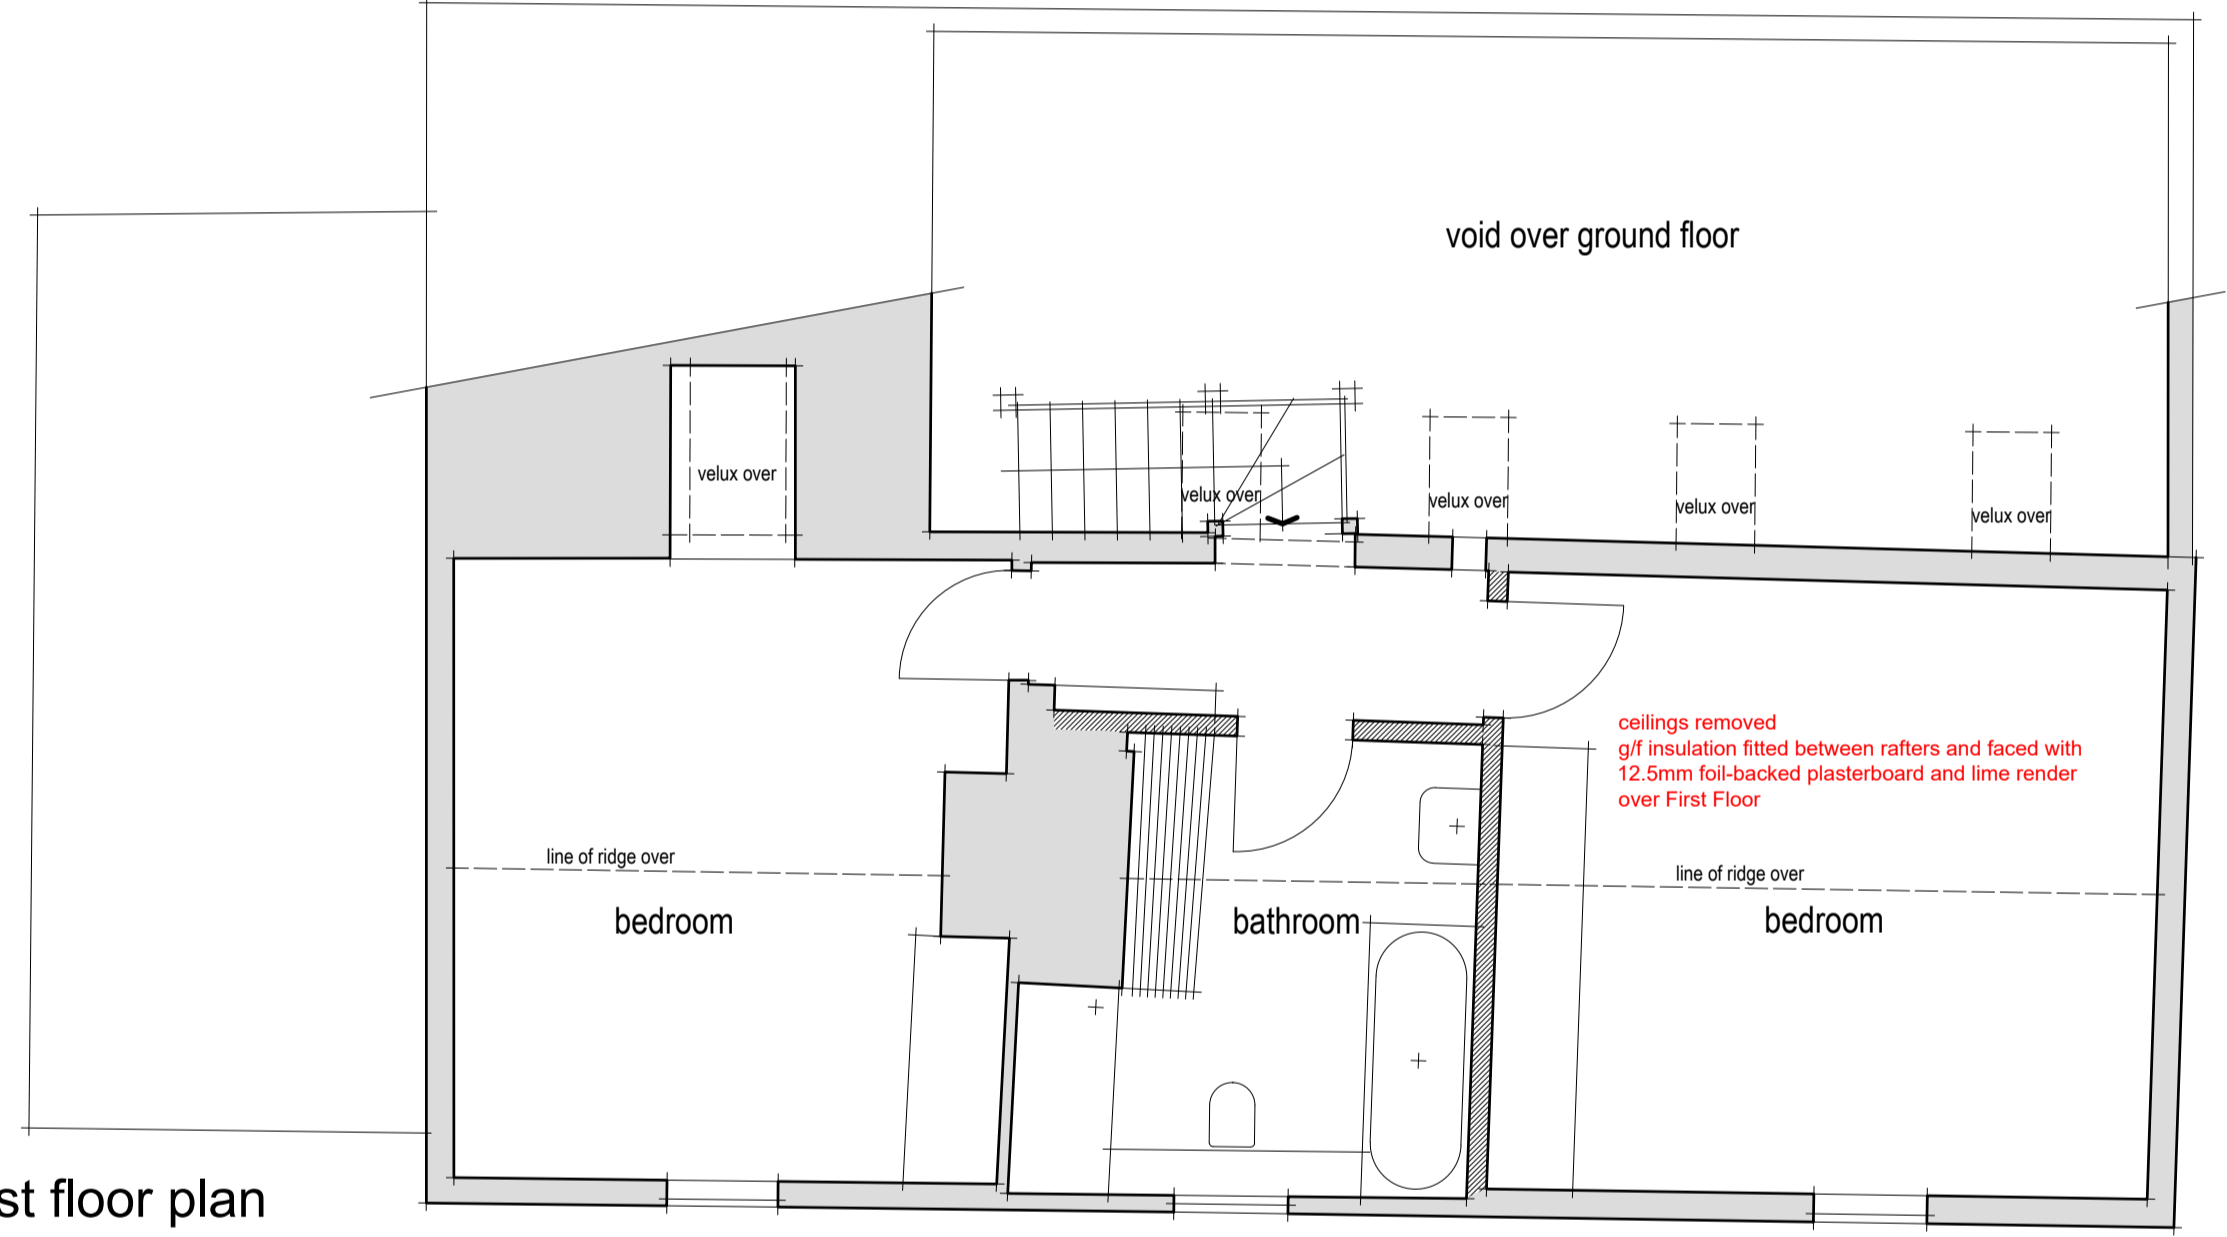


first floor plan

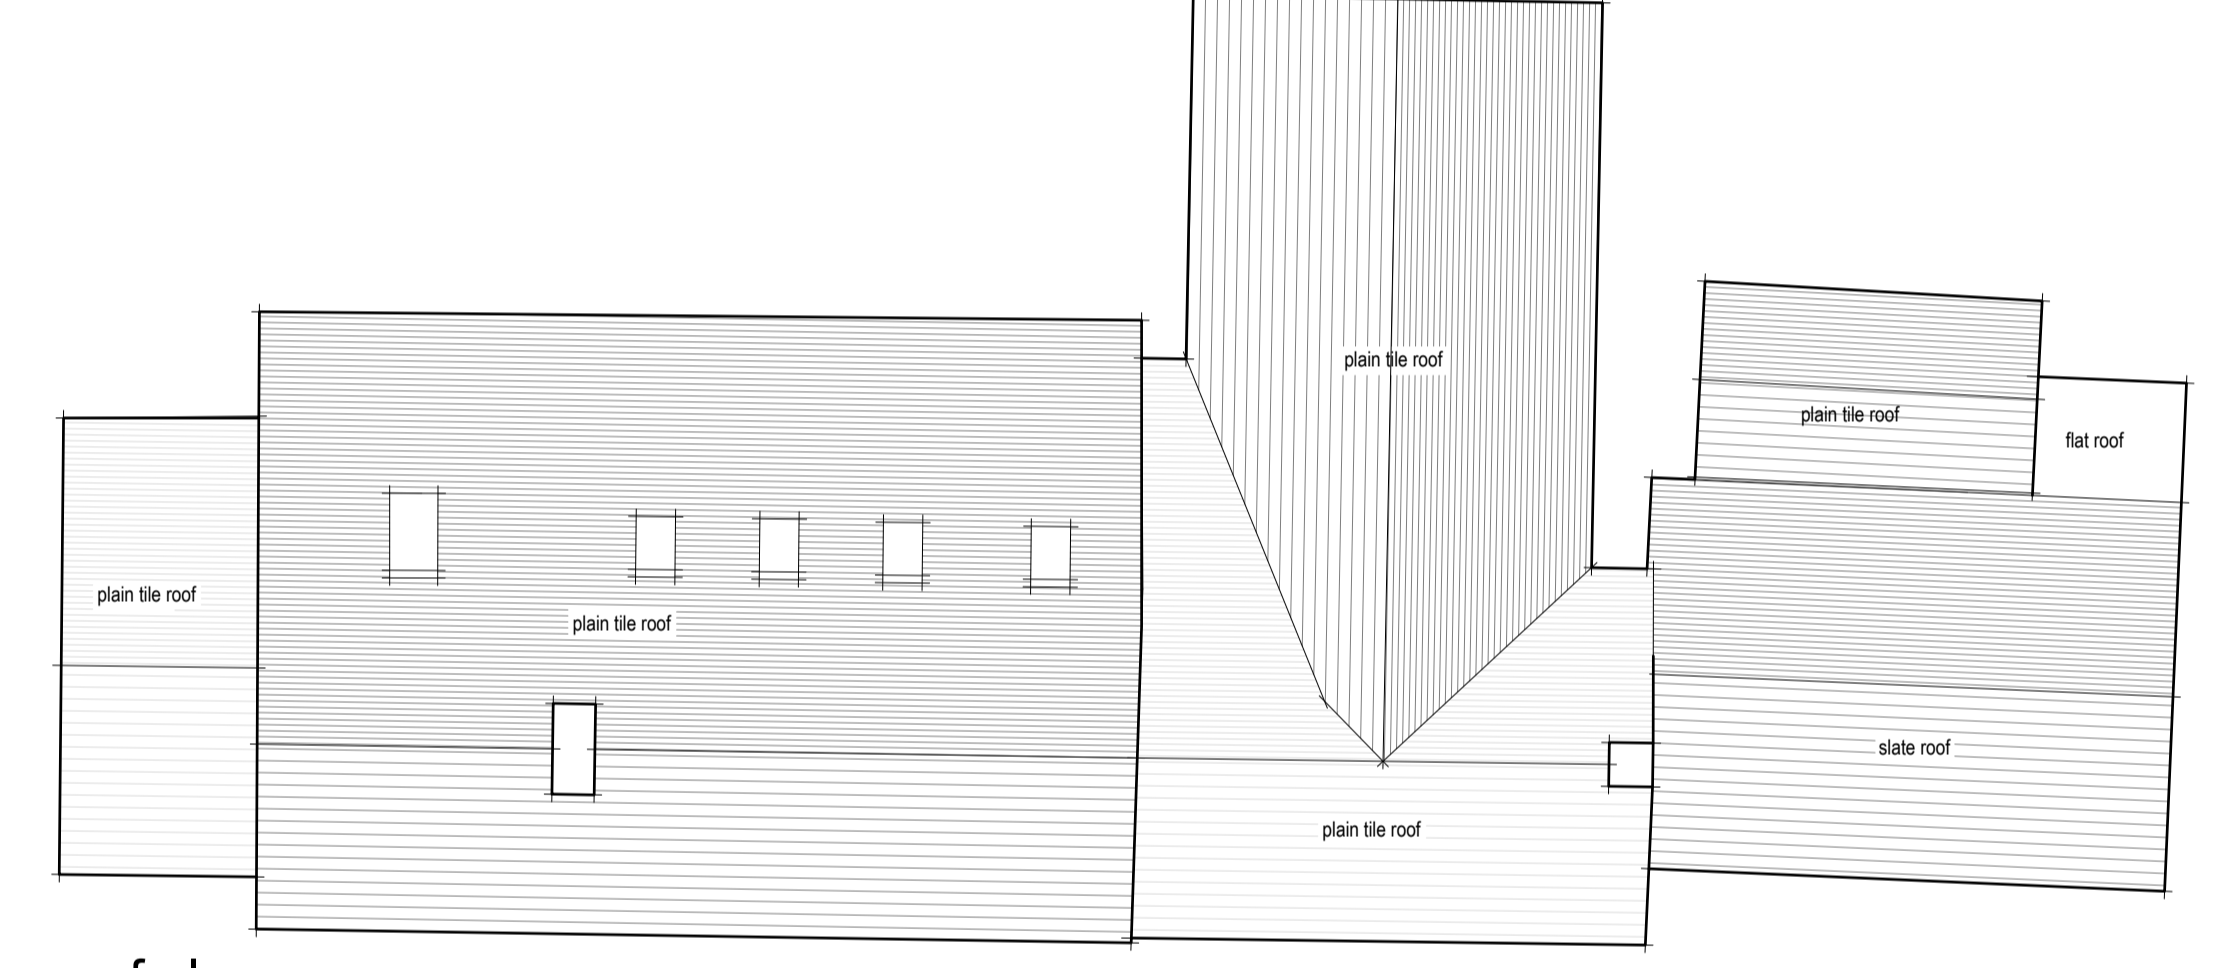

roof plan

PREMISES SHOWN AS SURVEYED ON 20 JULY 2016
 WORKS UNDERTAKEN WITHOUT LISTED BUILDING CONSENT SHOWN IN RED

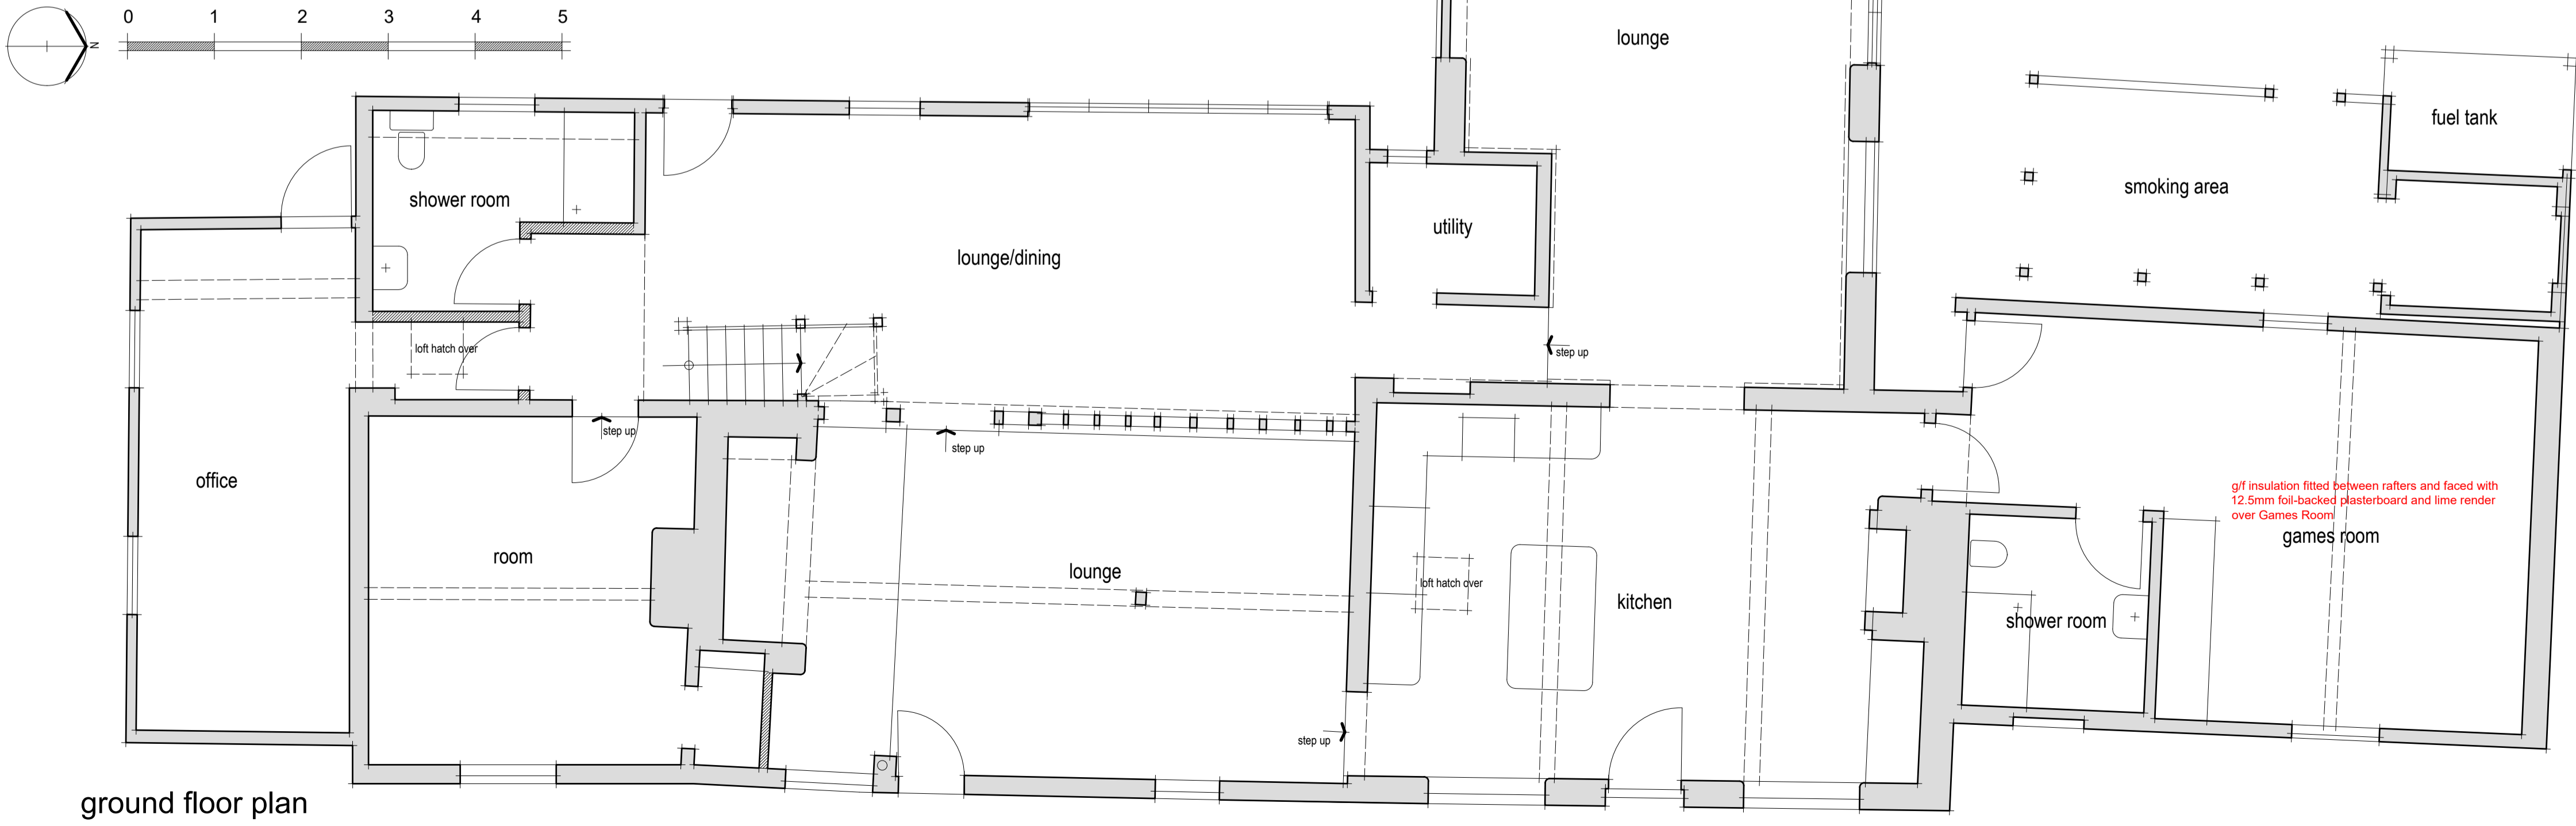

ground floor plan

PROJECT:	THE CABINET HIGH STREET REID HERTS SG8 8AH	<p>Parndon Mill Harlow Essex CM20 2HP T: 01279 444 904 E: info@sandds.co.uk W: www.sandds.co.uk</p>
DRAWING:	EXISTING PLANS SECTION ELEVATIONS	
DATE:	JUNE 2017	
SCALE:	1/50 1/100 at A1	
DRAWING NUMBER:	16/001/A/02 B	
DRAWN BY: MDC		CHECKED: