




NOTES / REVISIONS
 NOTE: THIS DRAWING MUST NOT BE SCALED.
 ALL DIMENSIONS TO BE CHECKED ON SITE BY THE CONTRACTOR AND ANY DISCREPANCIES ARE TO BE REPORTED BACK TO THE ARCHITECTS A BEFORE WORK COMMENCES.

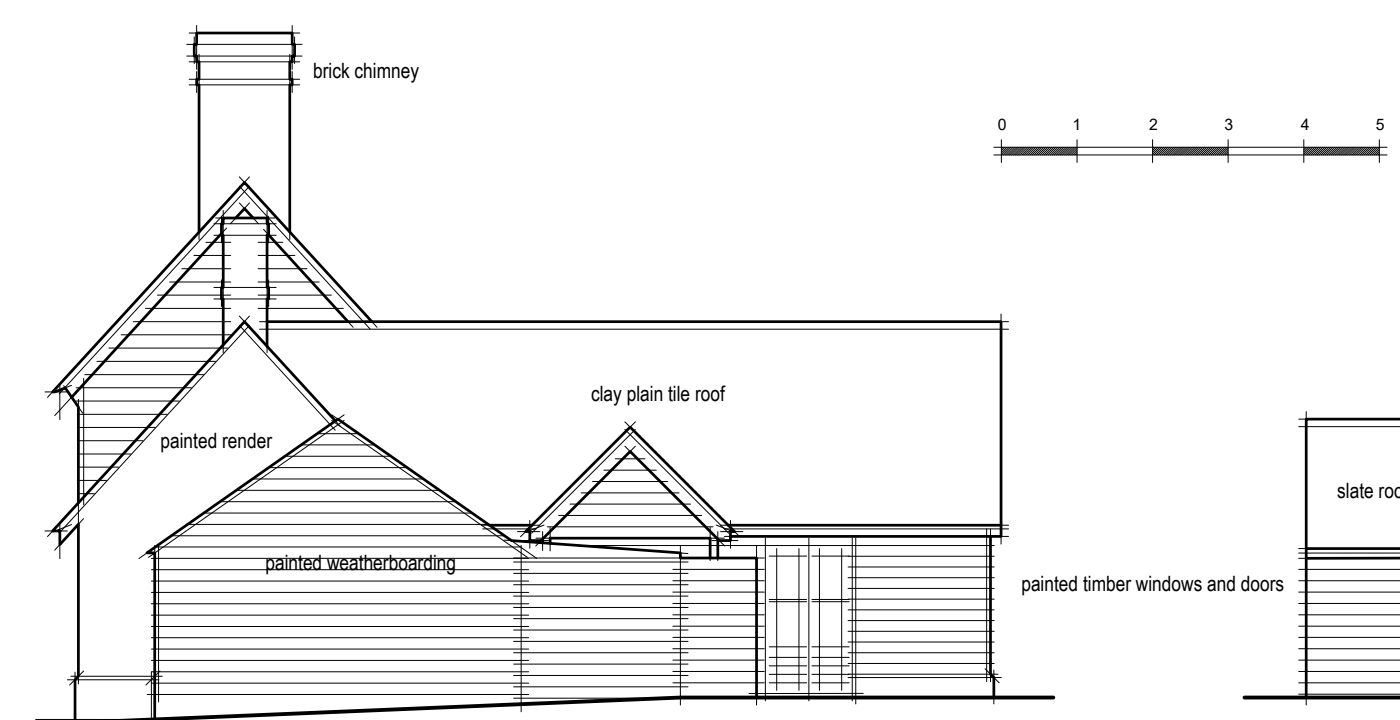


north elevation

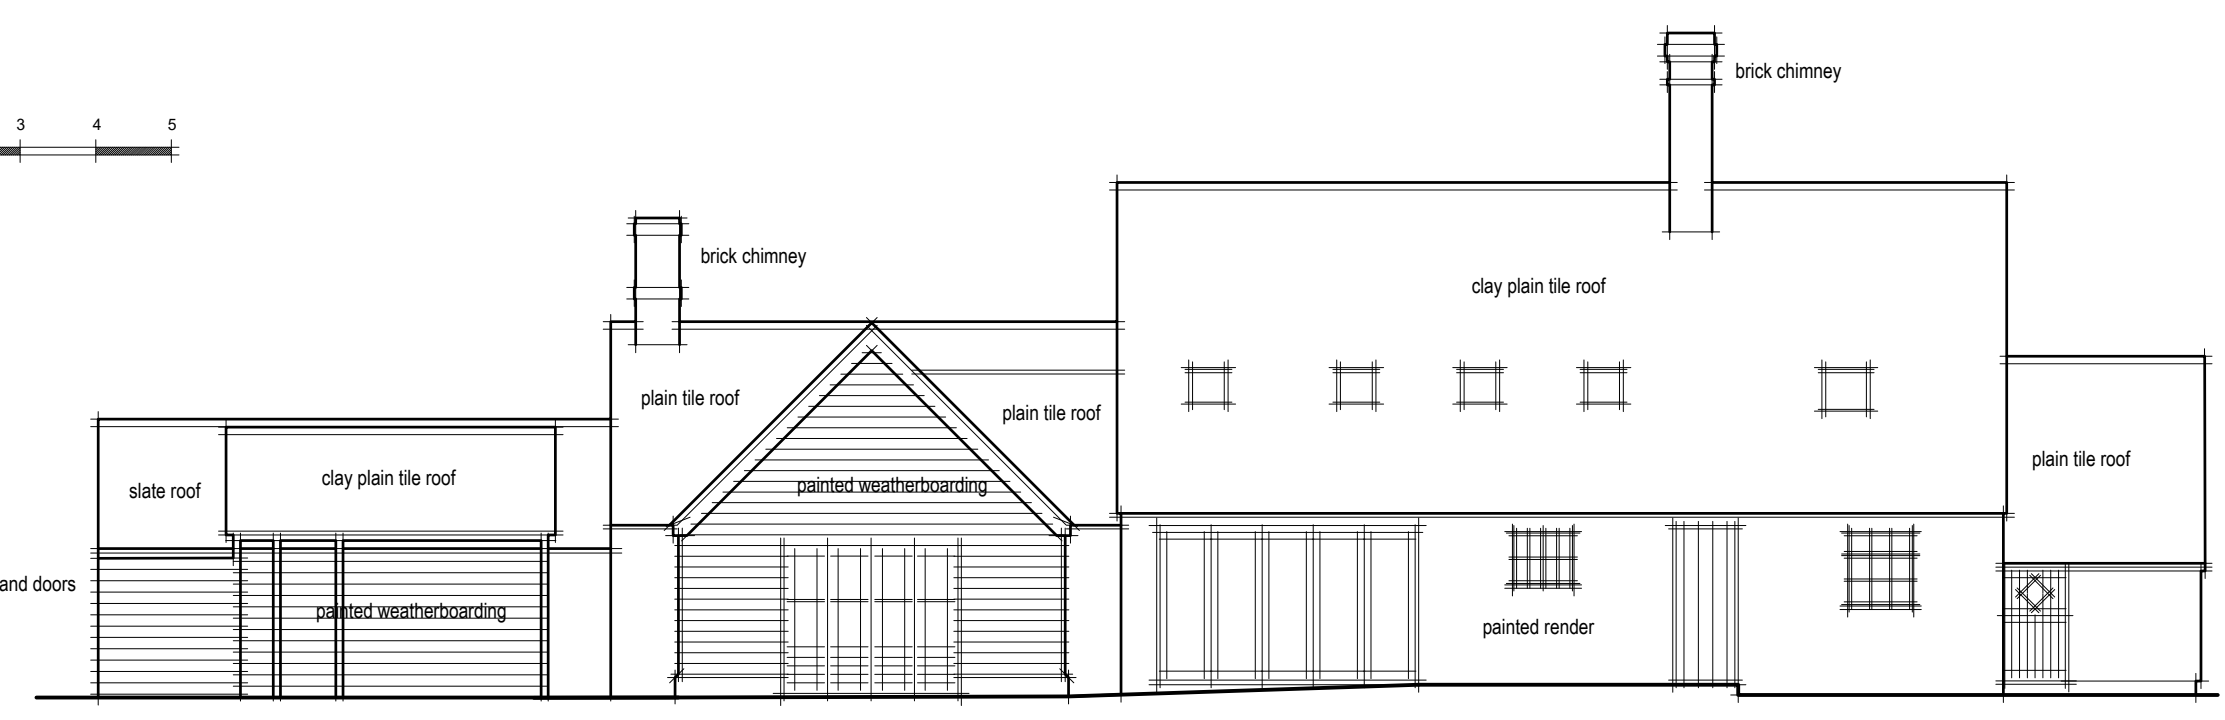


west elevation

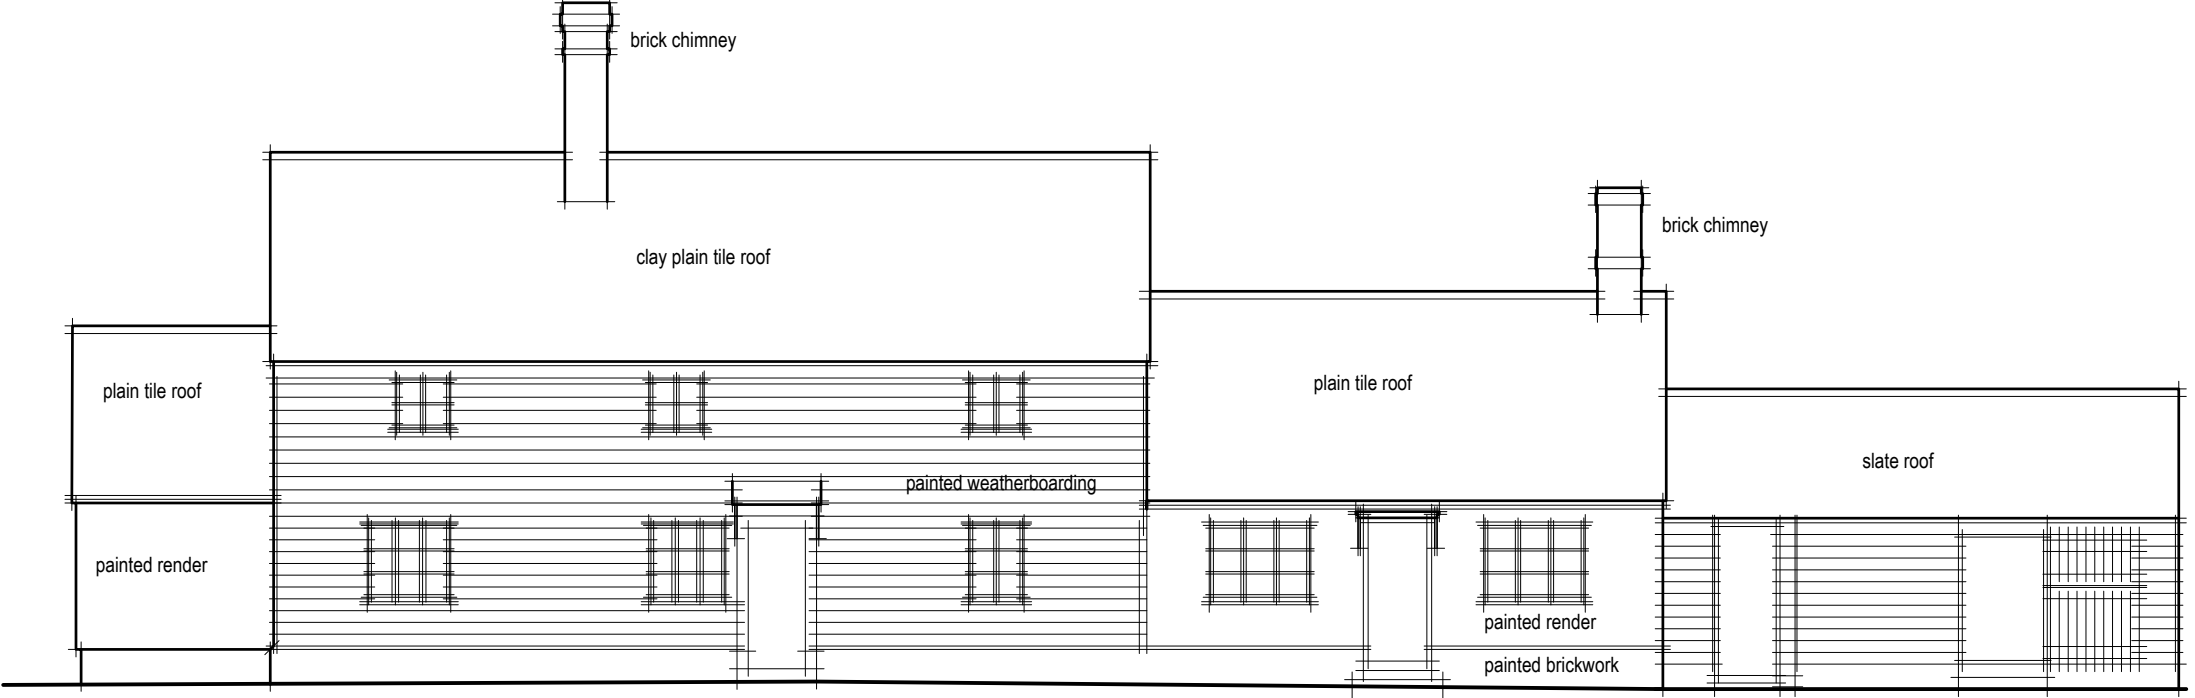


east elevation

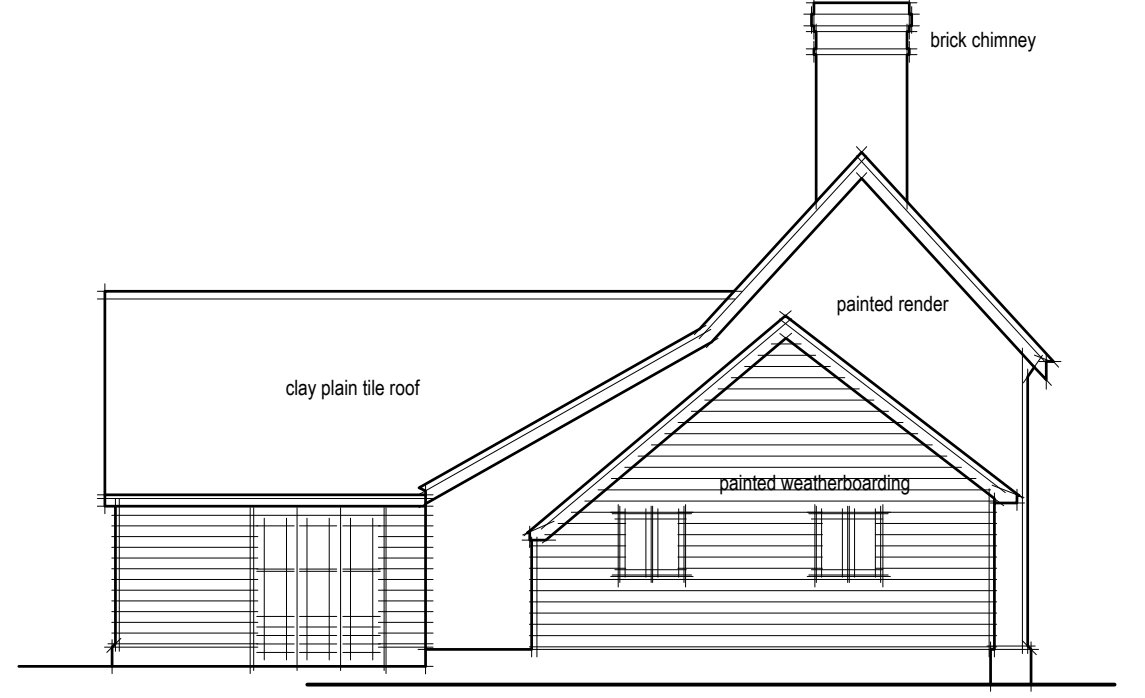


south elevation

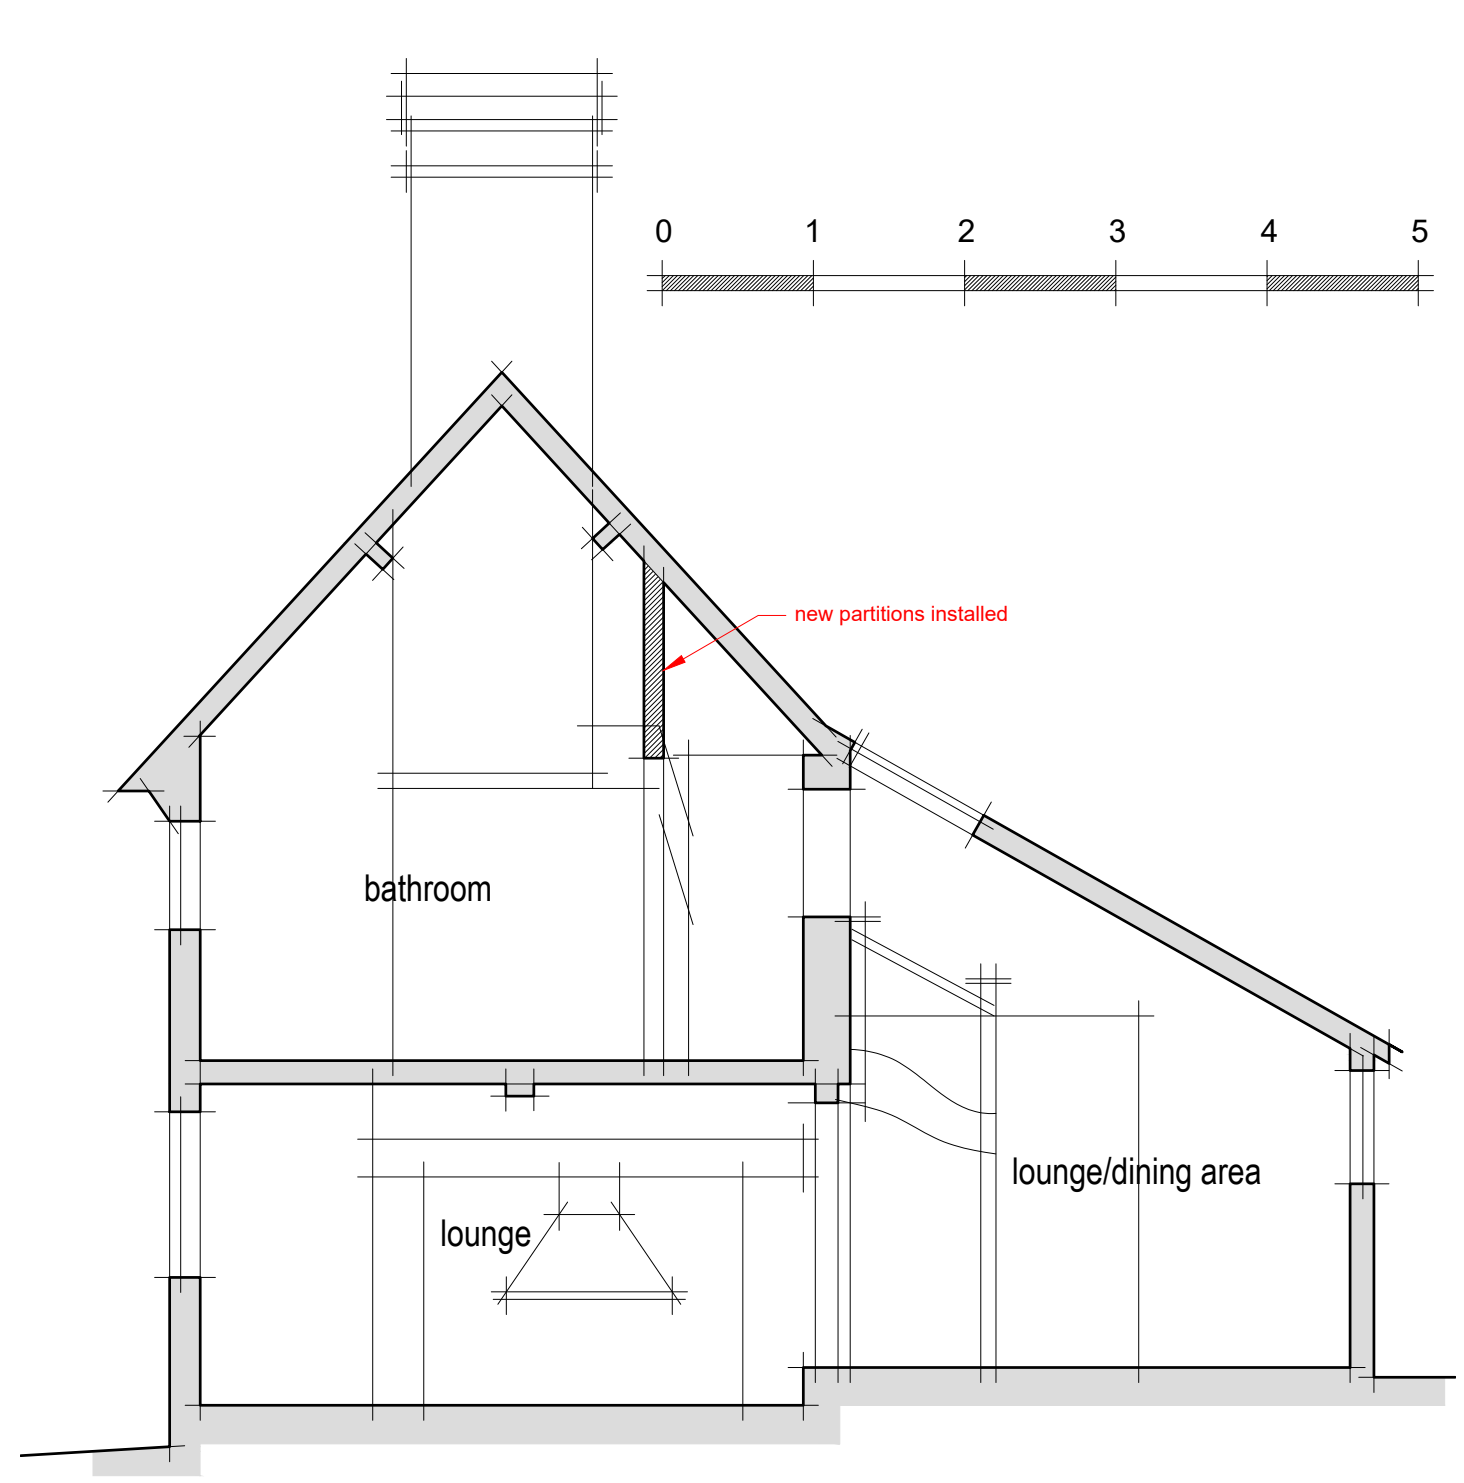


typical section

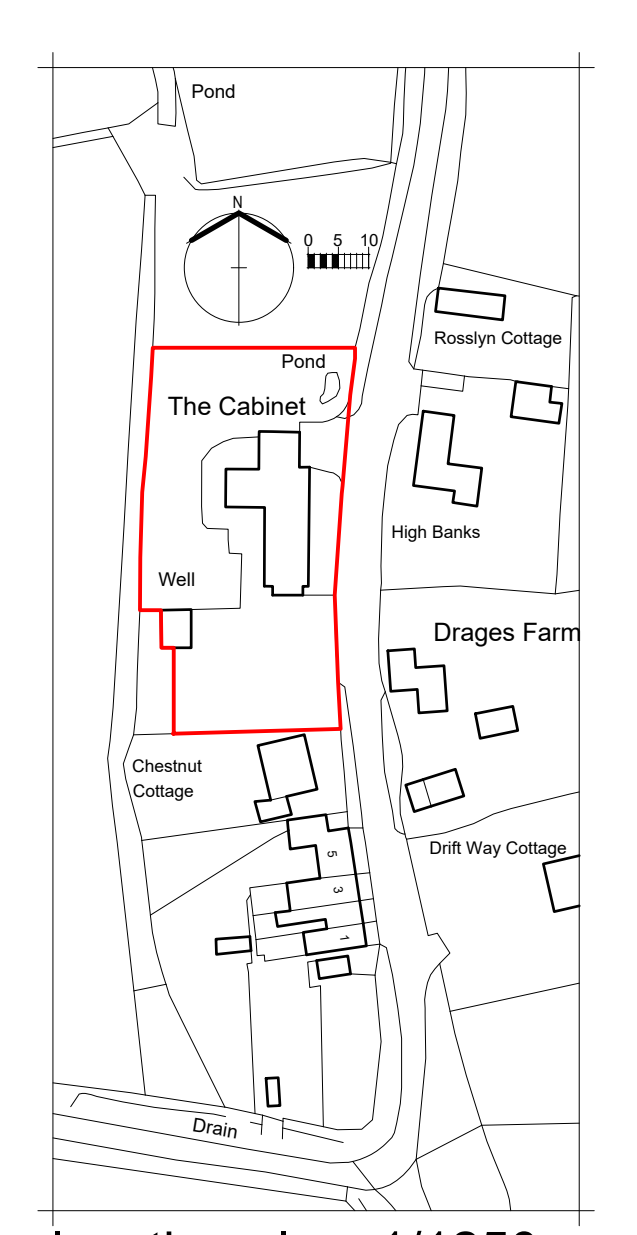

location plan 1/1250

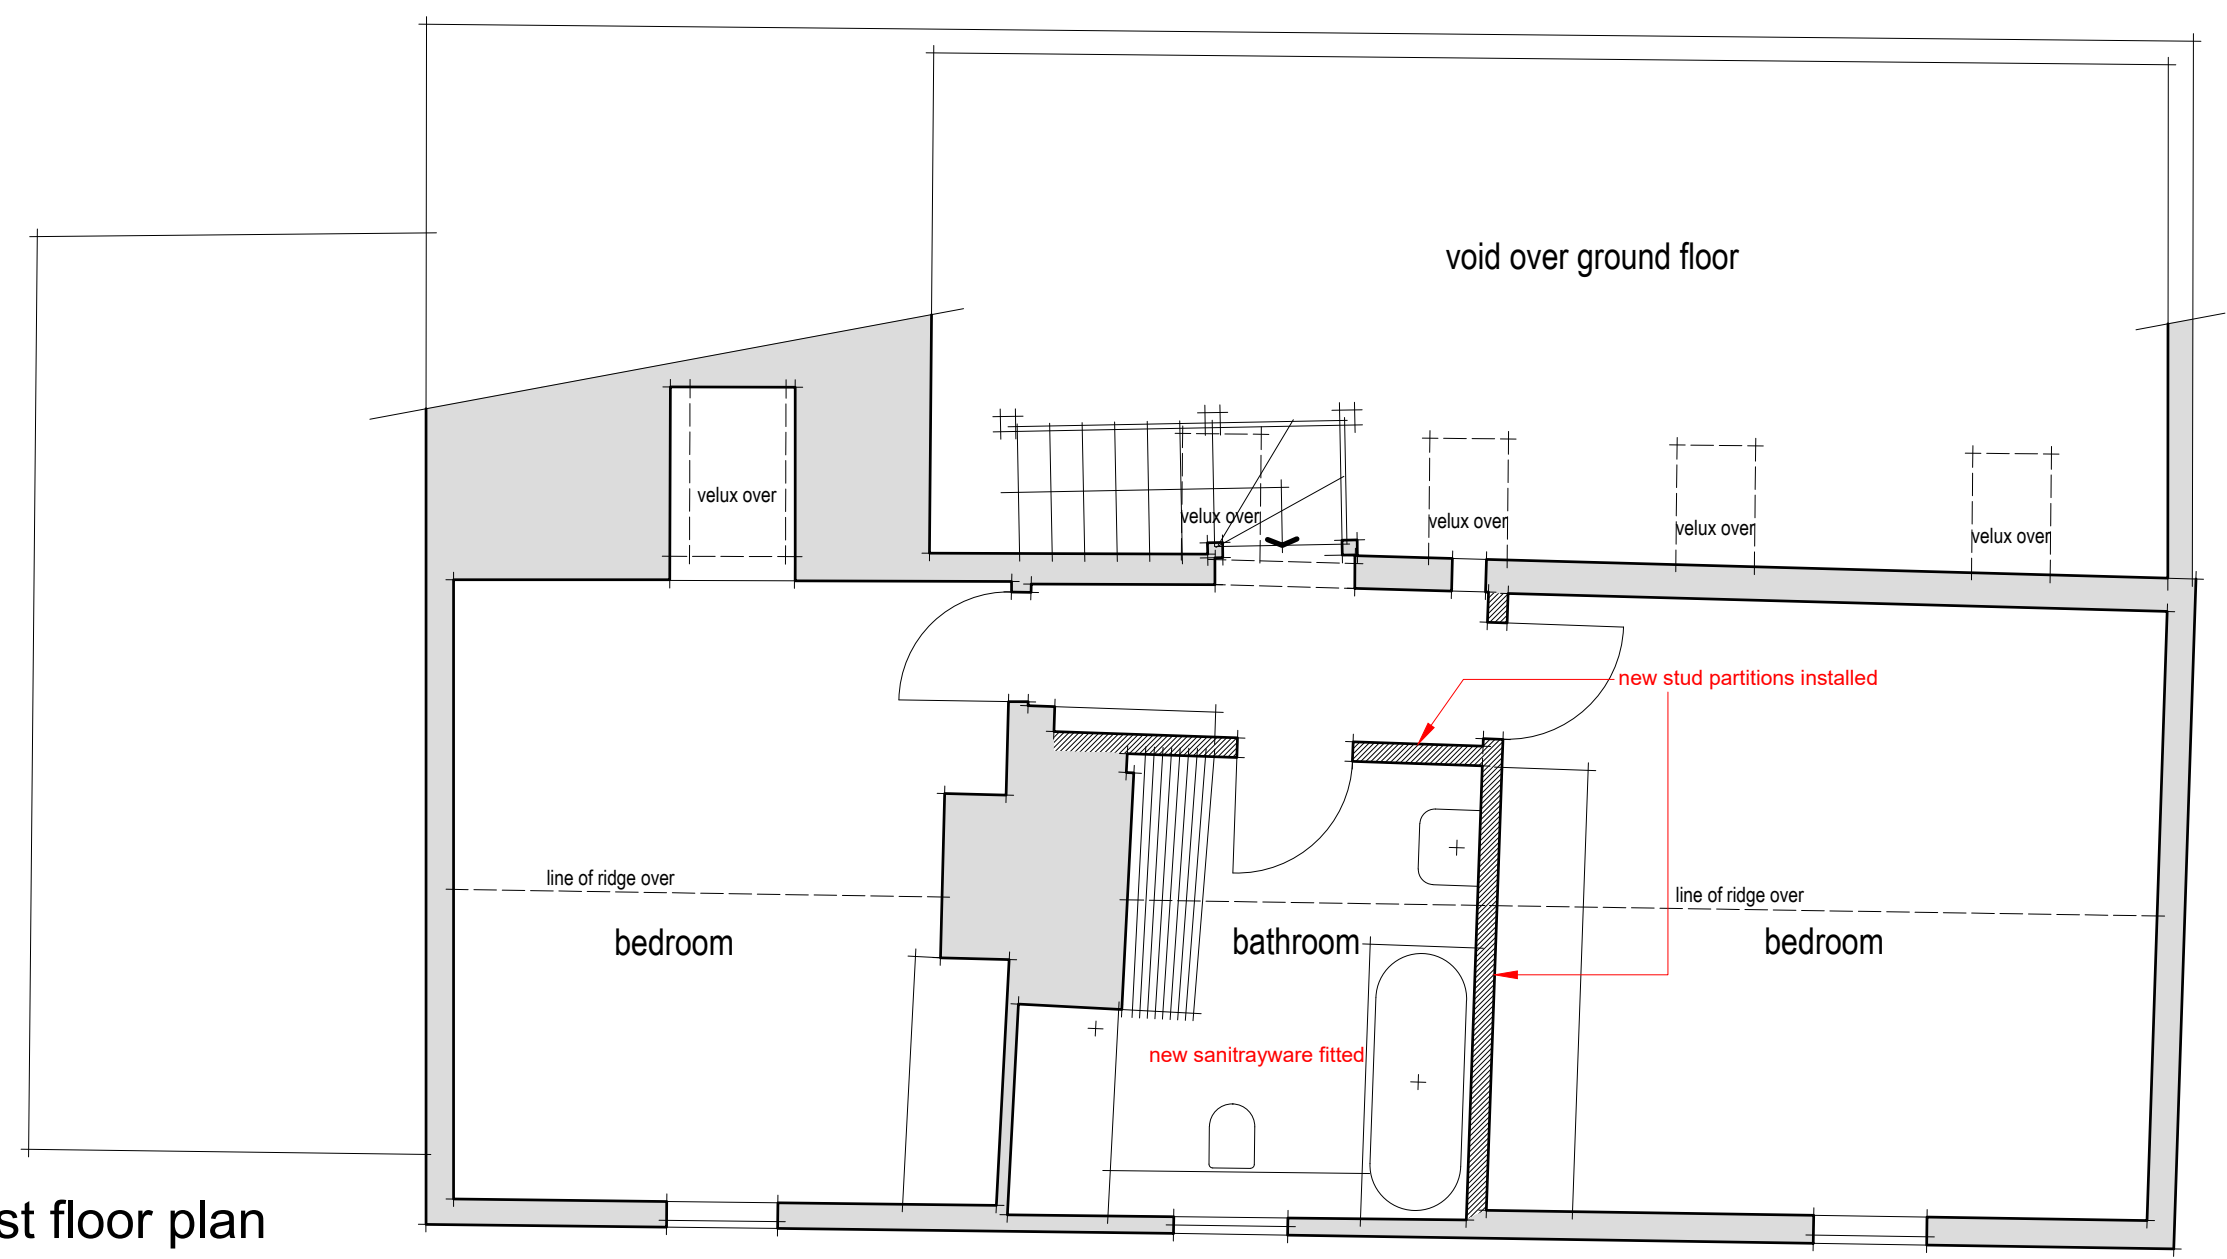


first floor plan

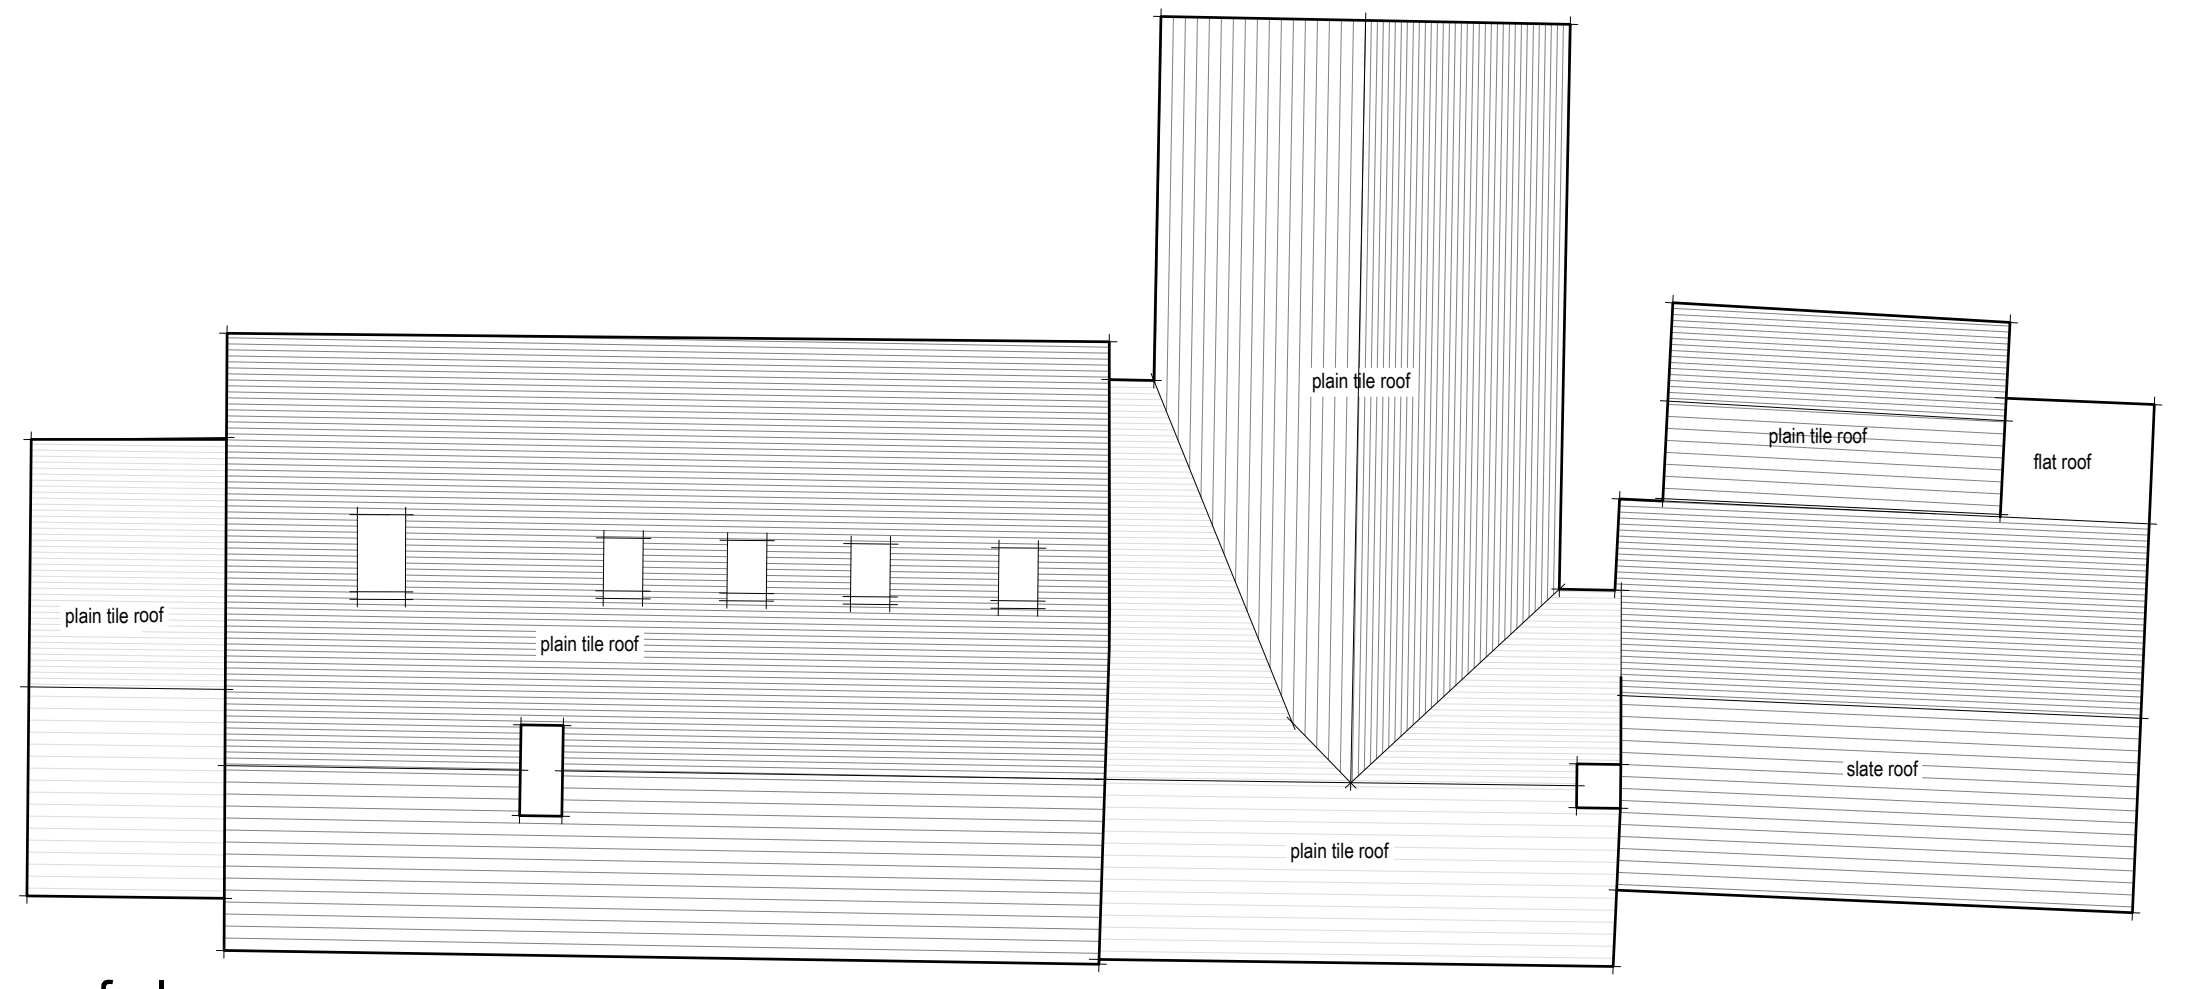

roof plan

PREMISES SHOWN AS SURVEYED ON 20 JULY 2016
 WORKS UNDERTAKEN BY CURRENT OWNER WITHOUT LISTED BUILDING CONSENT SHOWN IN RED

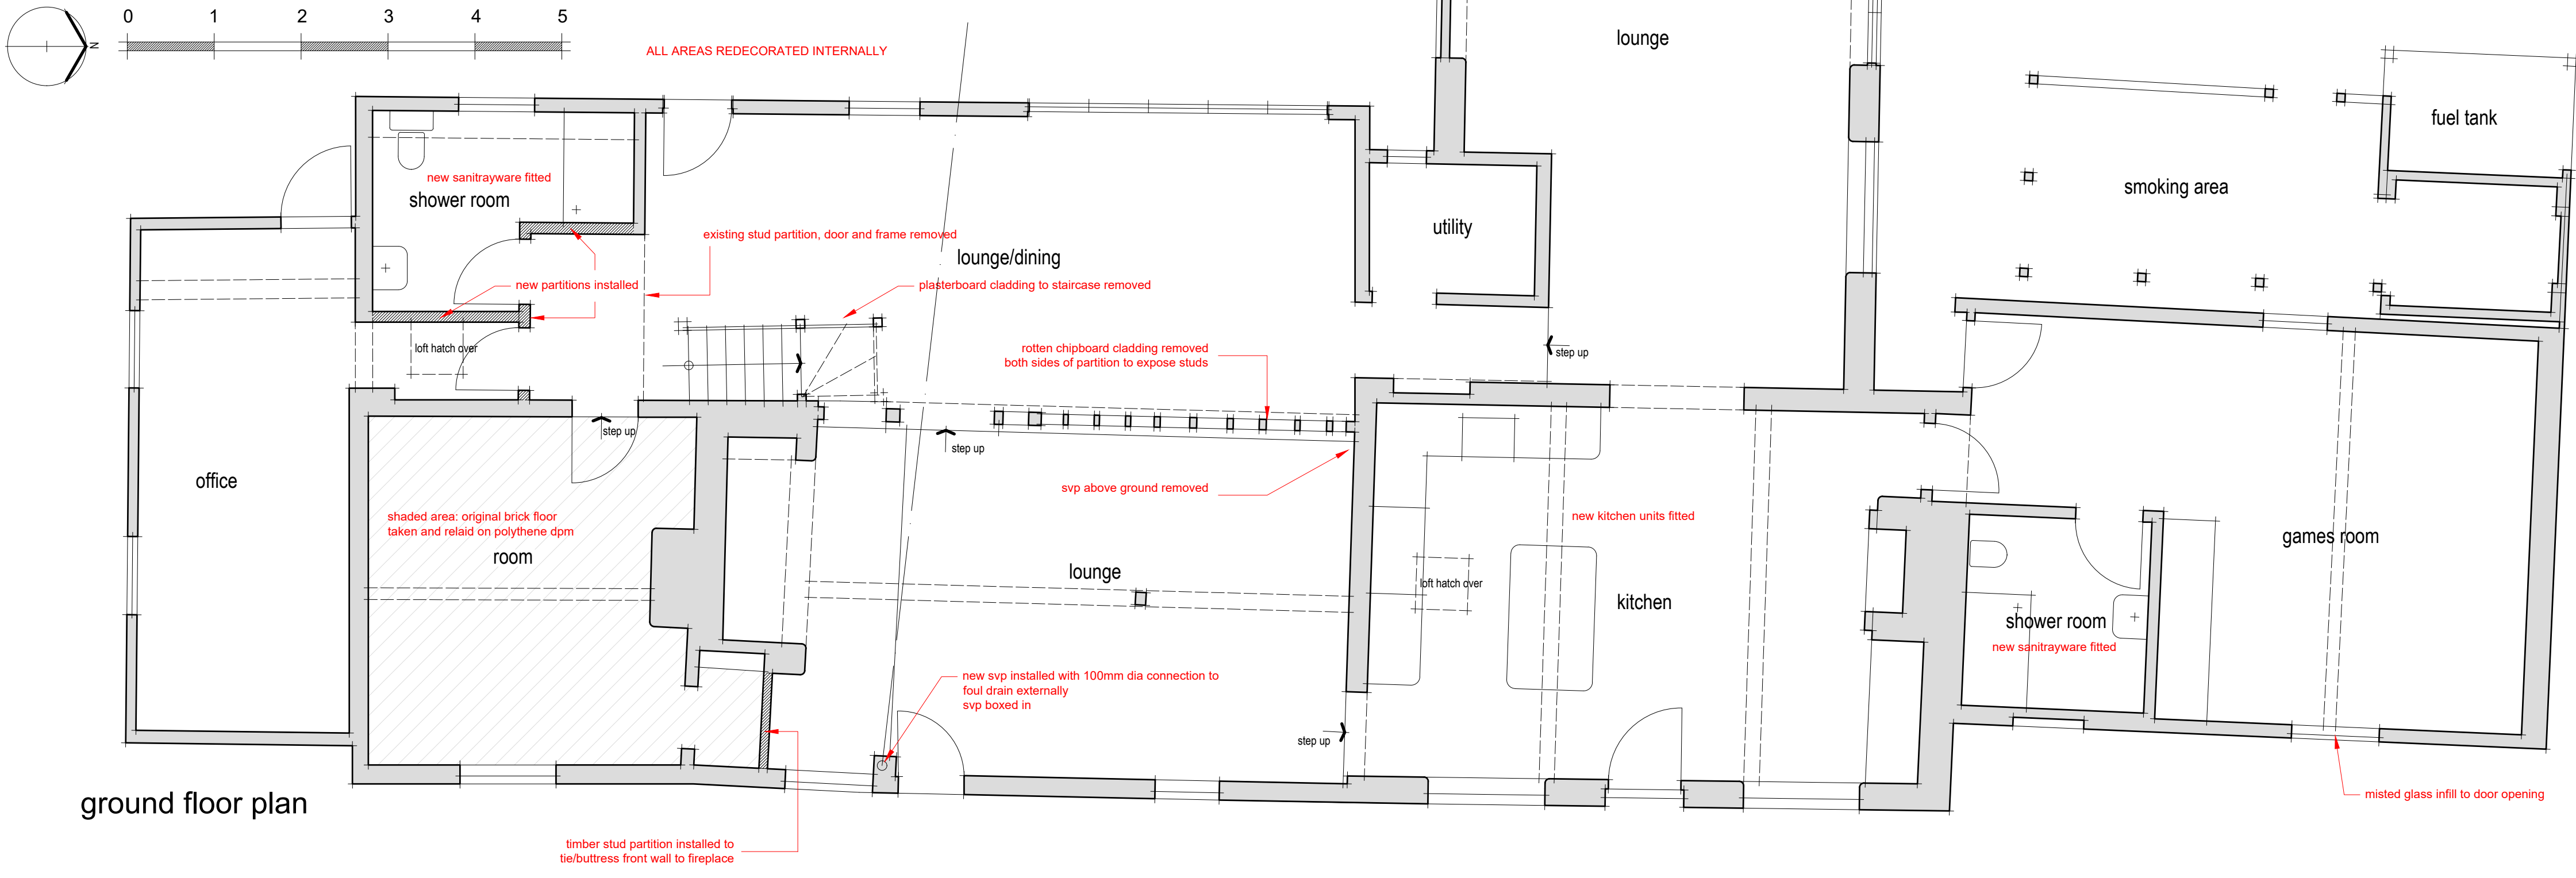

ground floor plan

revision a: roof lights added to western elevation - 1st september 2016 - mvc

PROJECT:	THE CABINET HIGH STREET REID HERTS SG8 8AH
DRAWING:	EXISTING PLANS SECTION ELEVATIONS
DATE:	AUG 2016
SCALE:	1/50 1/100 at A1
DRAWING NUMBER:	16/001/A/01 A
DRAWN BY:	MDC
CHECKED:	

architecture
 & design services ltd.

Parndon Mill | Harlow | Essex | CM20 2HP

T: 01279 444 904
 E: info@sandts.co.uk
 W: www.sandts.co.uk

